


T.6N.R.35E.W.M.

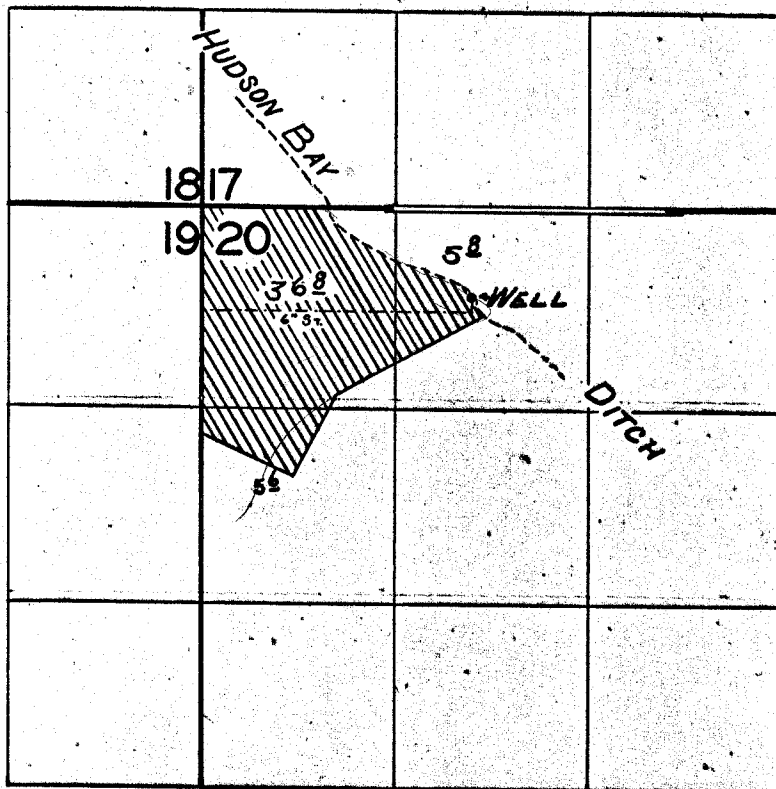

FINAL PROOF SURVEY
UNDER

Application No. G1426 Permit No. G1326
IN NAME OF

LAWRENCE McBRIDE

Surveyed JULY 16 1960, by M. BISH