


Well Permit Application of Lawrence McBride Rte 2 Box 184 M-F, Oregon

28731

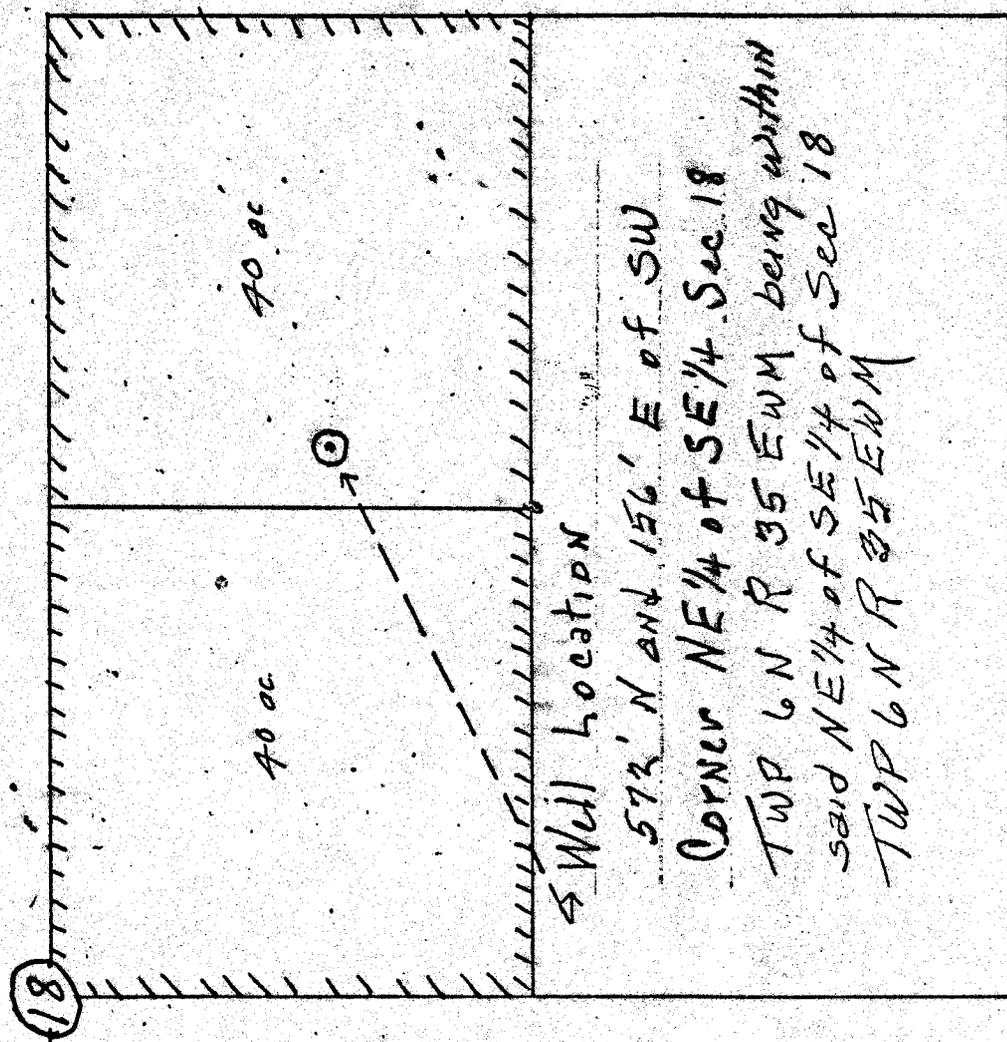

REGISTERED
 JUN 2 1953
 PROFESSIONAL ENGINEER
 STATE OF OREGON
 GALE...

Application No. G-142;
 Permit No. G-132
~~G-1327~~

Scale 1" = 525'

Appl. G-1427
 Per. G-1327