


T6N.R.35E.W.M.

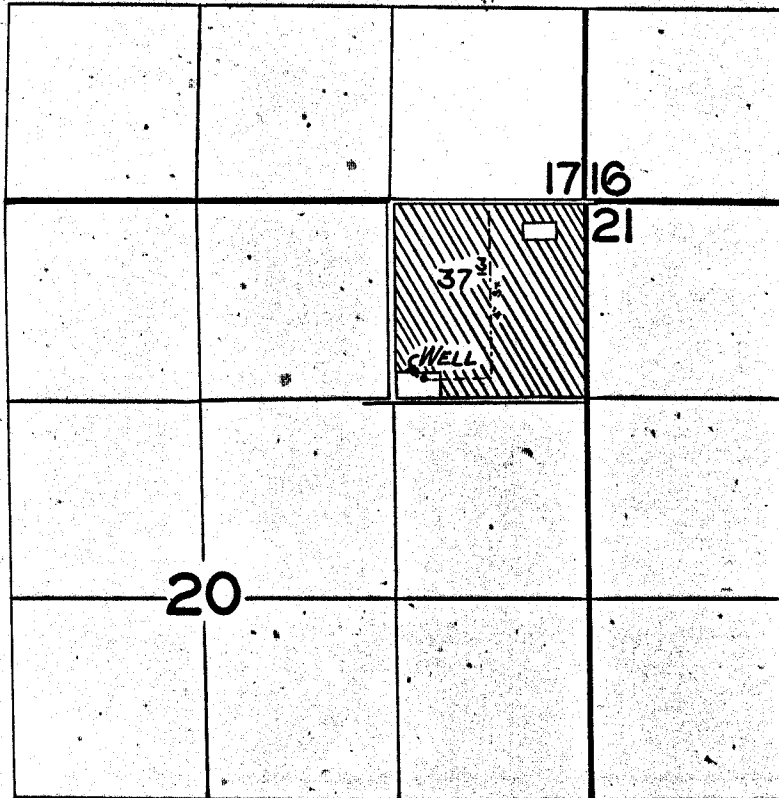

FINAL PROOF SURVEY UNDER

Application No. *G.1428*... Permit No. *G.1328*...
IN NAME OF

.....
Surveyed *JULY 15, 1960.*, by *M.BISH*.....