


G-1519  
28733

T6N.R.34E.W.M.

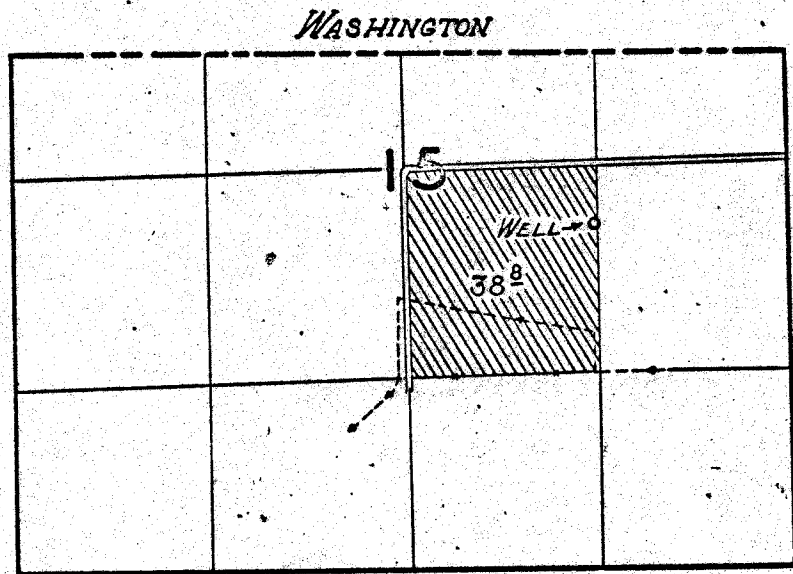

**FINAL PROOF SURVEY**  
UNDER

Application No. G-165B Permit No. G-1519  
IN NAME OF

KENNETH L. DICKERSON

Surveyed JULY 19 1960, by M. BISH