


T.3N.R28E.WM

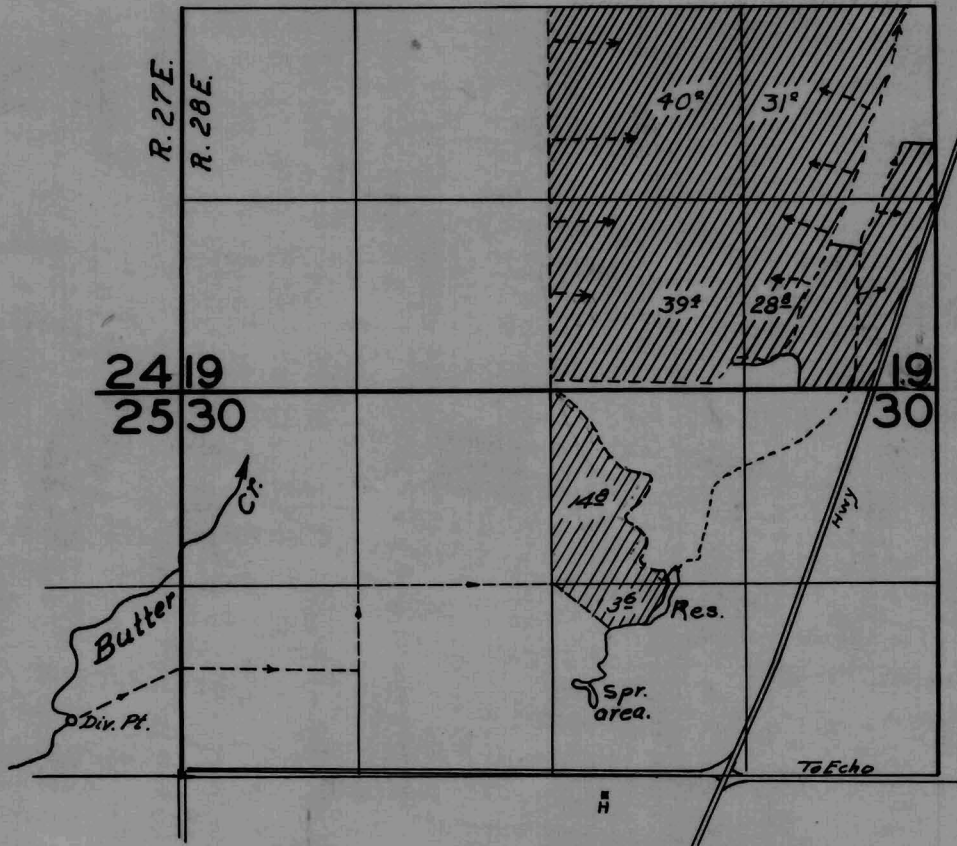

FINAL PROOF SURVEY
UNDER

Application No. 23 959 Permit No. 18911.2
IN NAME OF

GAYLORD M. MADISON

Surveyed NOV. 15. 1958, by M. BISH

NZ-2F-173

NZ 2F-173