


T.3N.R.35E.W.M.

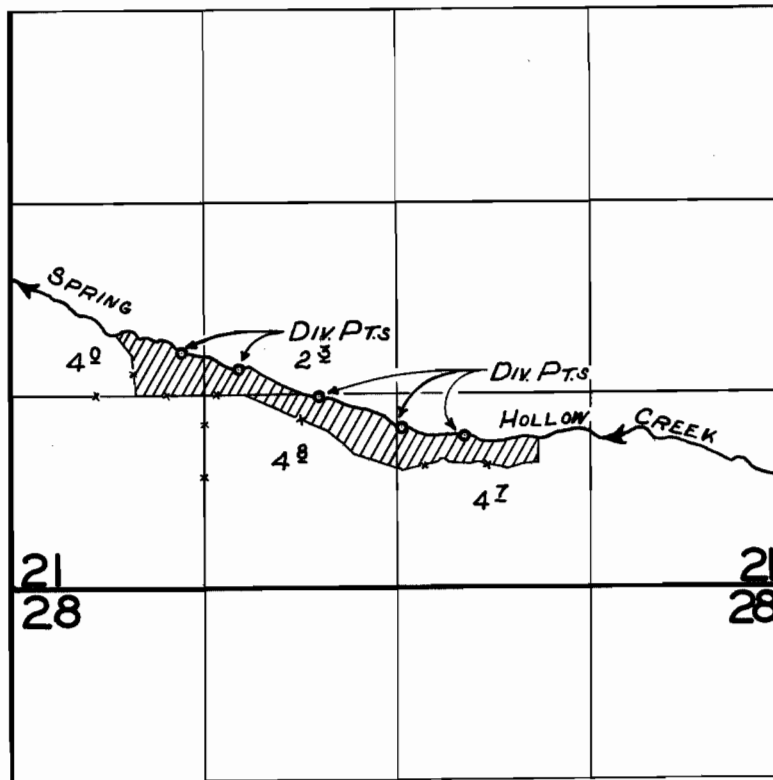

FINAL PROOF SURVEY
UNDER

Application No. 29195 Permit No. 23114
IN NAME OF

HAROLD BARNETT

Surveyed JULY 21, 1960, by M. BISH