


T. 3N. R. 28E. W.M.

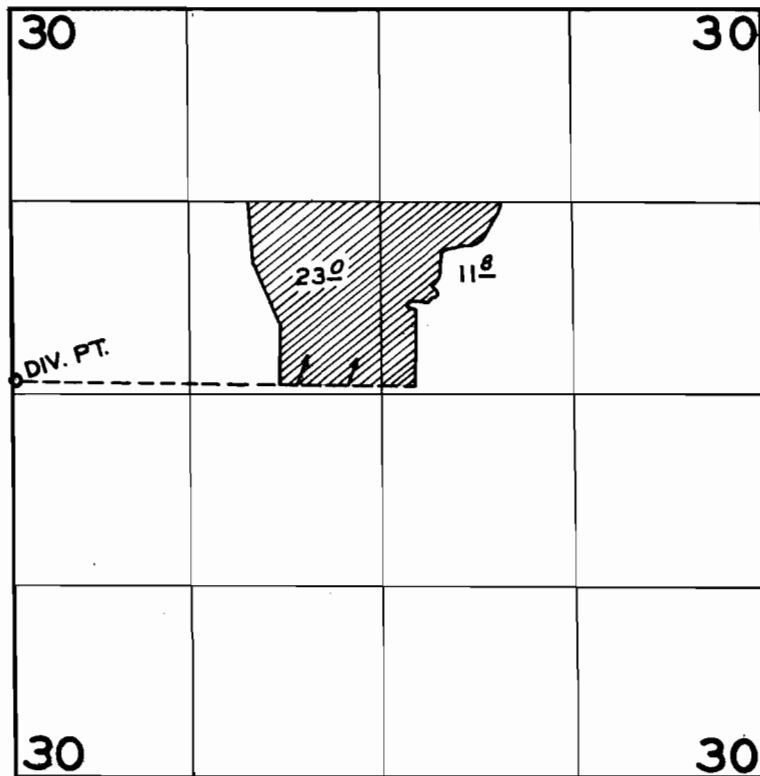

FINAL PROOF SURVEY
UNDER

Application No. 33224 Permit No. 26400
IN NAME OF

GAYLORD M. MADISON

Surveyed JULY 21 1960, by [Signature]