

C-2874
T 7312


MCKINNON DITCH

CROOK CO.

5781
3545

212

T. 14 S. R. 17 E. W.M.

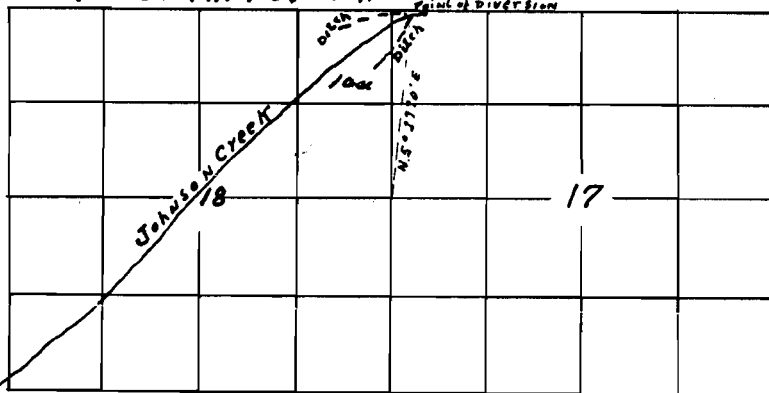

3545