


T. 1 S. R. 4 W. W. M.

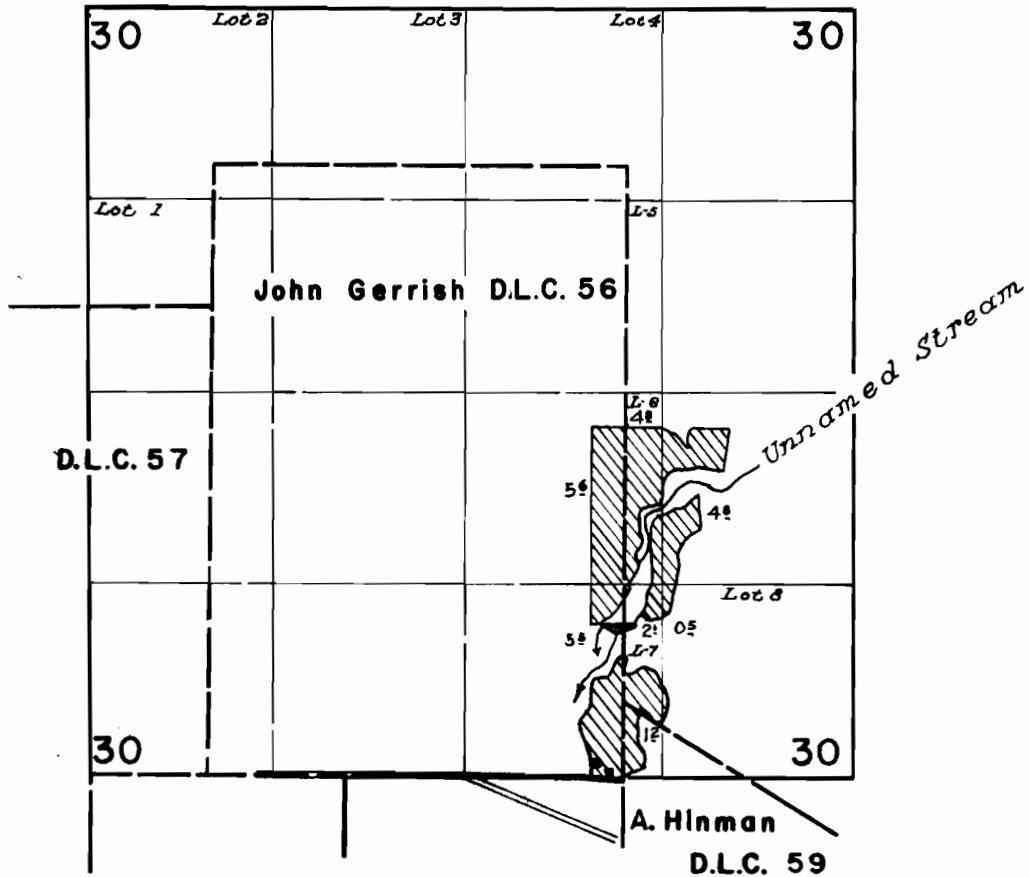

FINAL PROOF SURVEY UNDER

Application No. 25531 R-28253 28254 Permit No. 20054 R-1488 22218
IN NAME OF

MRS. PAUL D. ZINKE

Surveyed June 2 1960, by

A. Jackson