


T.2S.R.1W.W.M.

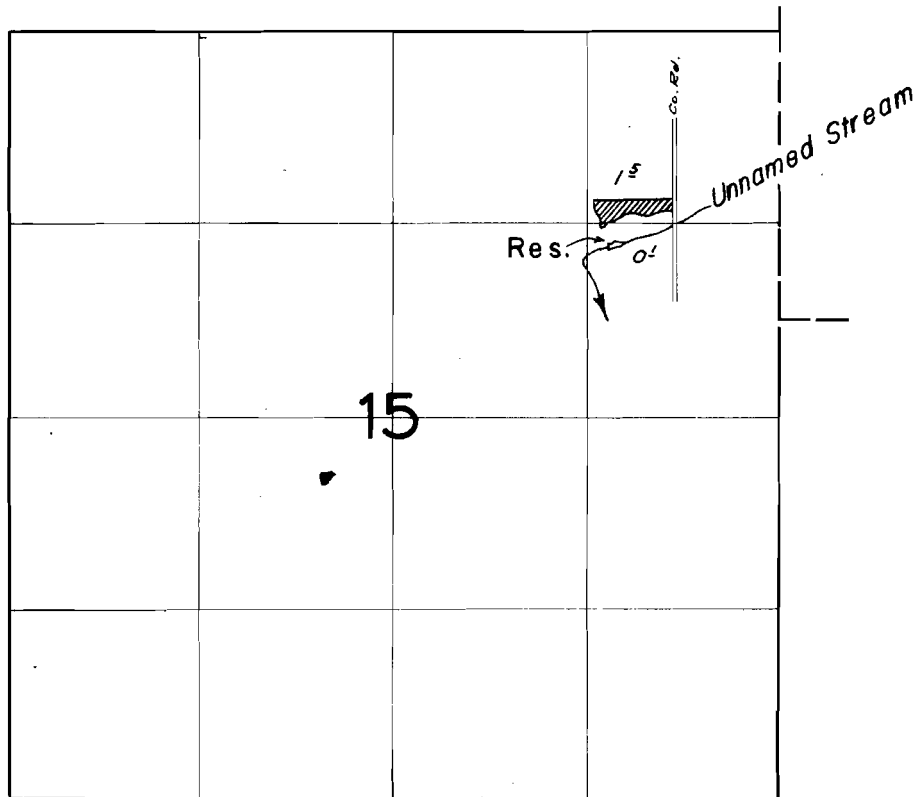

**FINAL PROOF SURVEY**  
UNDER

*R26982*                      *R1343*  
Application No. *26983* Permit No. *21194*  
IN NAME OF

**LUCY L. LEONARD**

Surveyed *Sept. 14 1959* by *C.O. Bartels*  
*July 8 1960*                      *R.H. Jackson*