


T. 1S. R. 4 W.W.M.

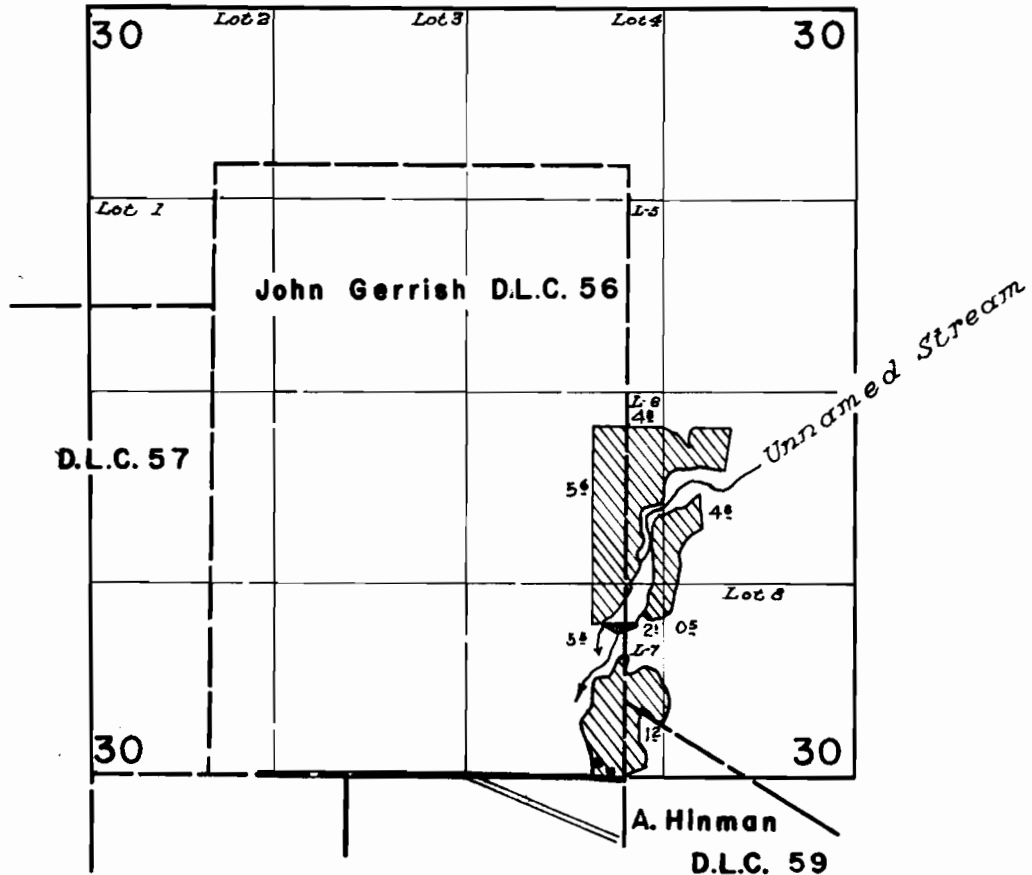

FINAL PROOF SURVEY UNDER

25531 20054
R-28253 R-1488
Application No. 28254 Permit No. 22218
IN NAME OF

MRS. PAUL D. ZINKE

Surveyed June 2 1960, by

A. Jackson