


T.2S.R.1W.W.M.

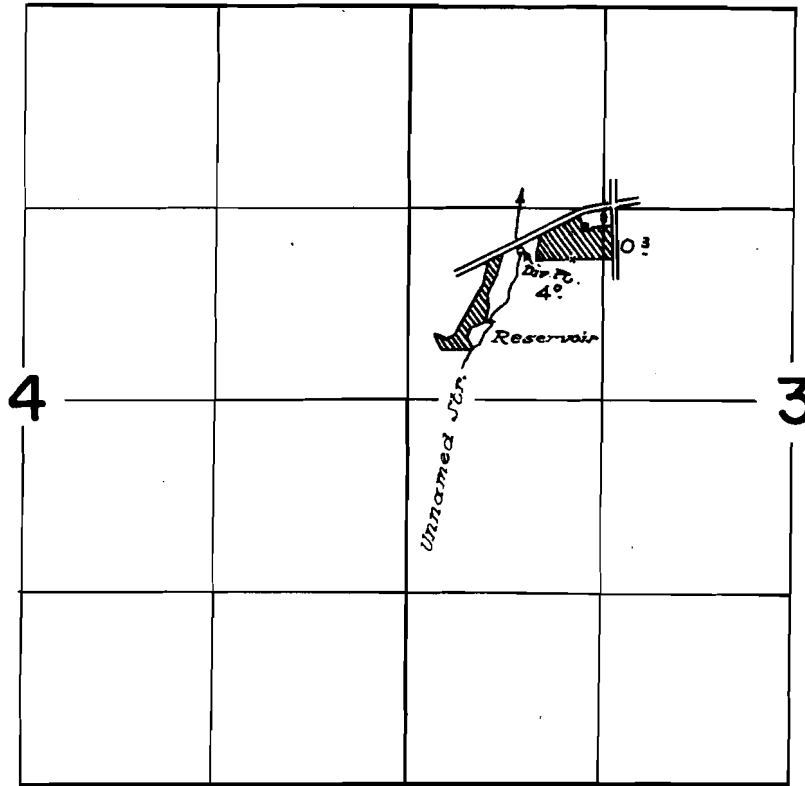

FINAL PROOF SURVEY
UNDER

R-30294 R-1771
Application No. 30295 Permit No. 23729
IN NAME OF

F. CLIFTON CURL

Surveyed June 3, 1960, by *A. Jackson*