


T. 1 S. R. 3 W. W. M.

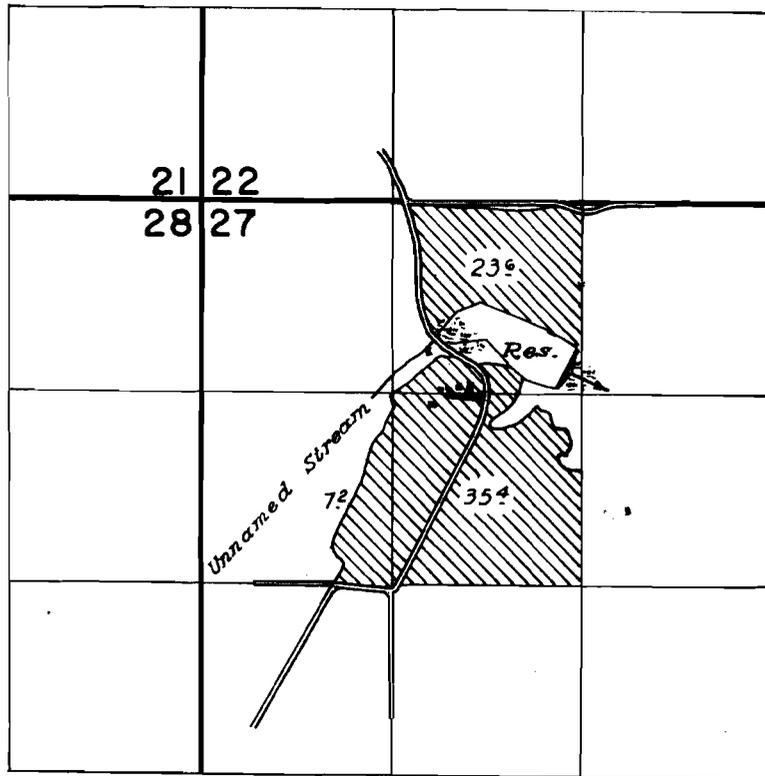

FINAL PROOF SURVEY UNDER

R-30559 R-1846
Application No. 30560 Permit No. 24108
IN NAME OF

GlenRoy Spangler

Surveyed June 20 1960, by

Alf Peterson