


# T. 1 S. R. 3 W. W. M.

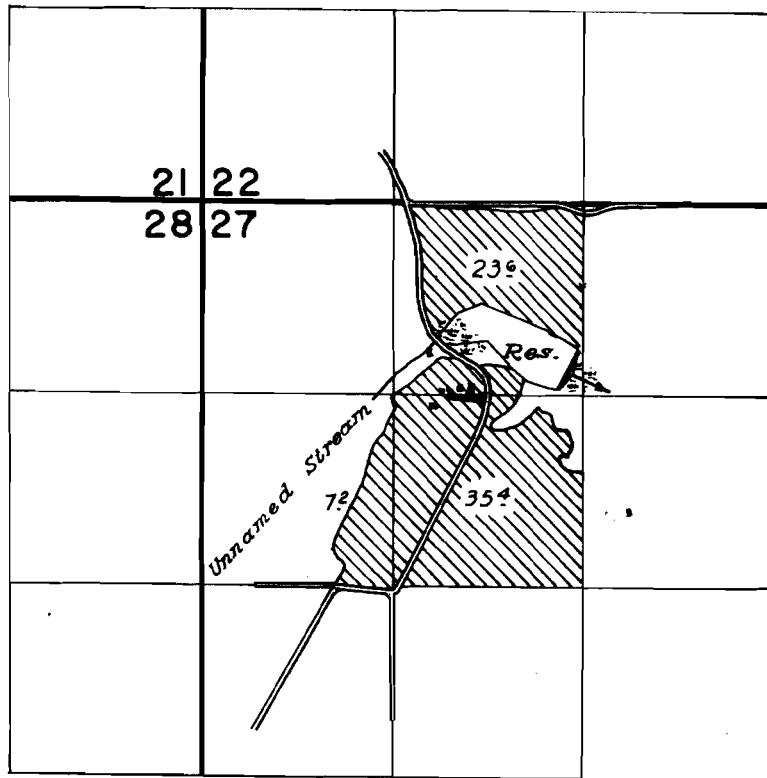

## FINAL PROOF SURVEY UNDER

R-30559                      R-1846  
Application No. 30560    Permit No. 24108  
IN NAME OF

**GlenRoy Spangler**

Surveyed June 20 1960, by

*Alf Peterson*