


T. 1N. R. 3W. W.M.

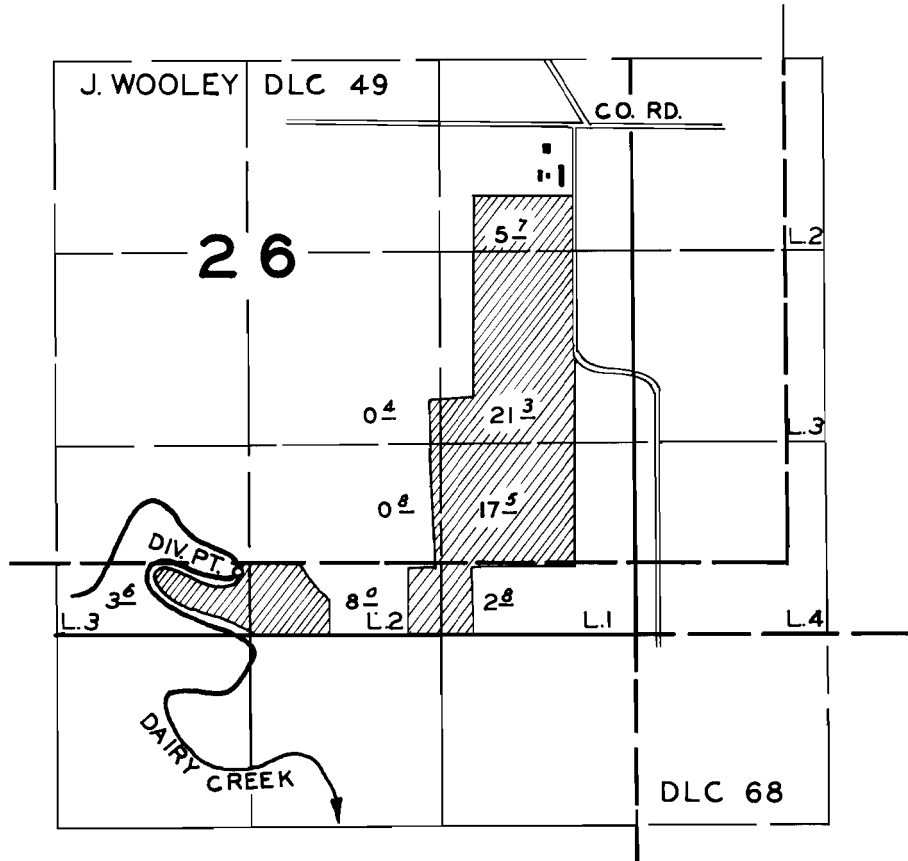

FINAL PROOF SURVEY UNDER

Application No. 30639 Permit No. 24138
IN NAME OF

JOHN W. GATES

Surveyed SEPT. 8 1960, by R.H. JACKSON