


# T. 1S. R. 2W.W.M.

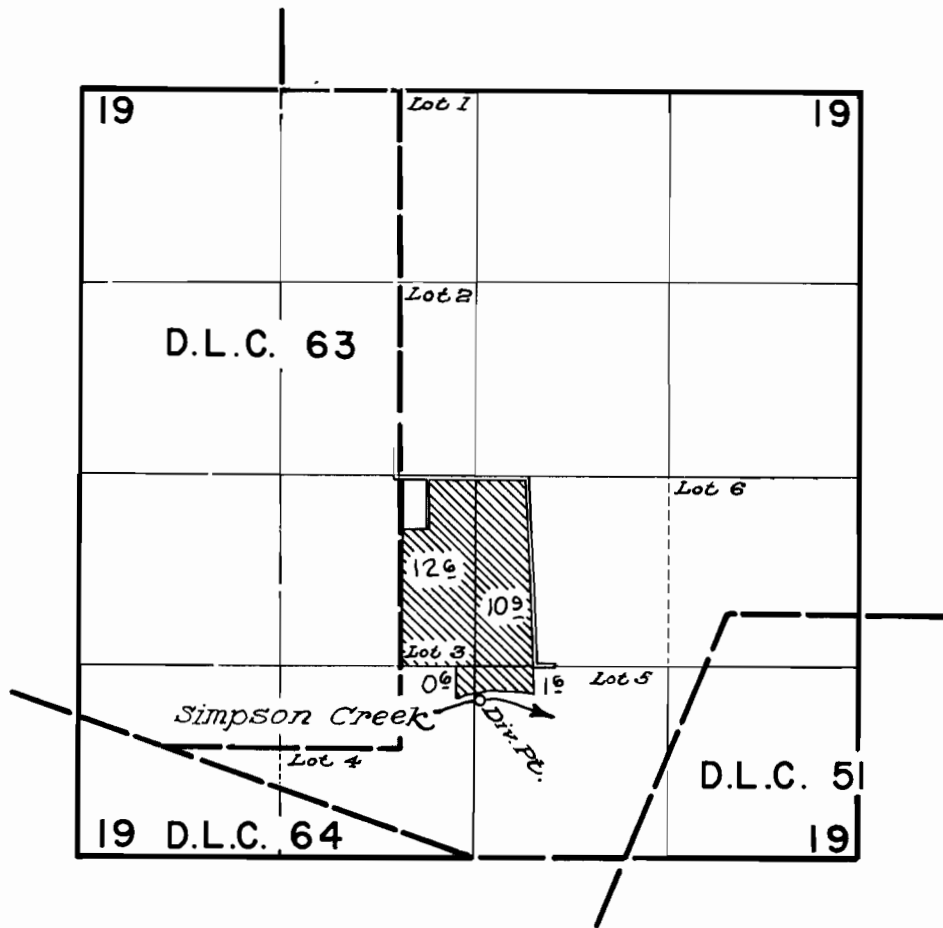

## FINAL PROOF SURVEY UNDER

Application No. 30822 Permit No. 24262  
IN NAME OF

**ELDEN R. & THERESA W. McROBERT**

Surveyed June 22, 1960, by *[Signature]*