


T.2S.R.1&2W.W.M.

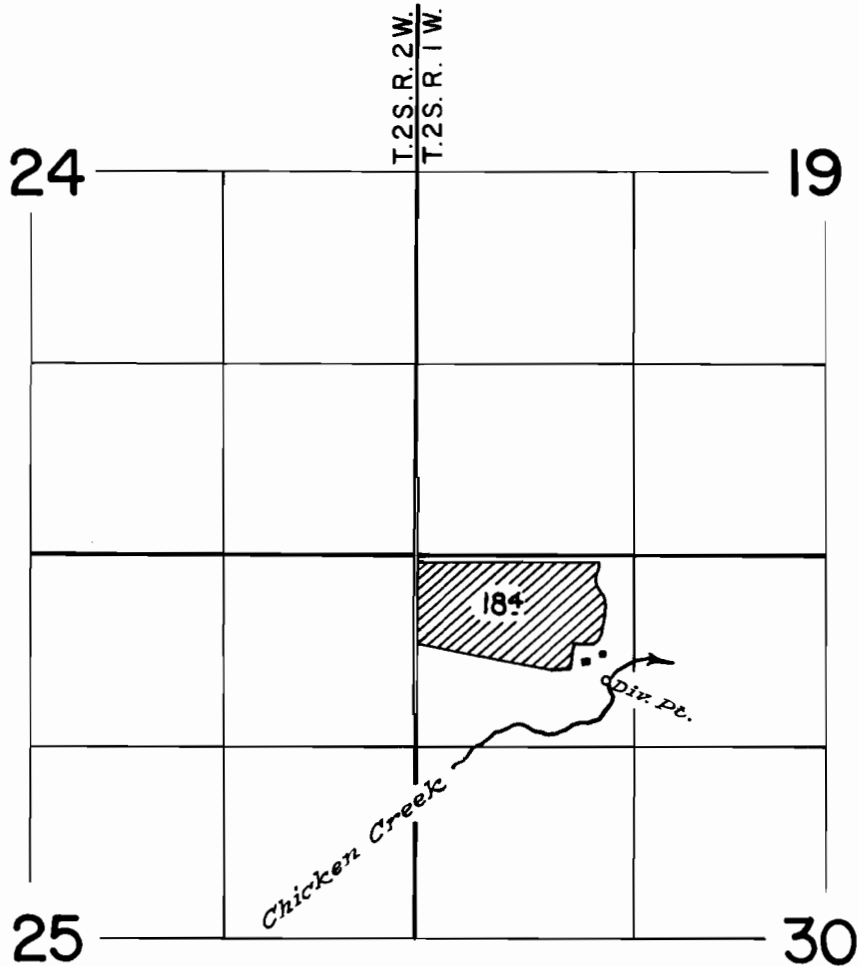

FINAL PROOF SURVEY
UNDER

Application No. 31121 Permit No. 24476
IN NAME OF

HERBERT ELWERT

Surveyed June 24 1960, by *R. Jackson*