


T.1N. R.4W.W.M.

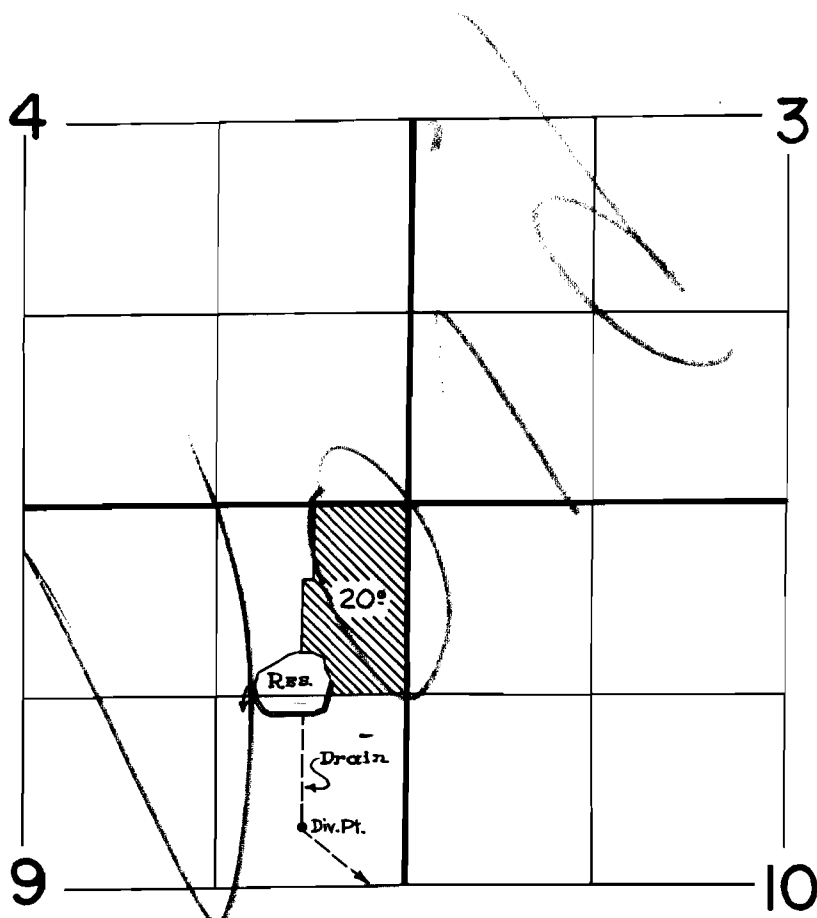

FINAL PROOF SURVEY UNDER

Application No. R-31189 31190 Permit No. R-1970 24606
IN NAME OF

ALVIN H. & THERESA M. MEURY

Surveyed Sept. 6, 1960, by [Signature]