


T. 2S. R. 2W. W.M.

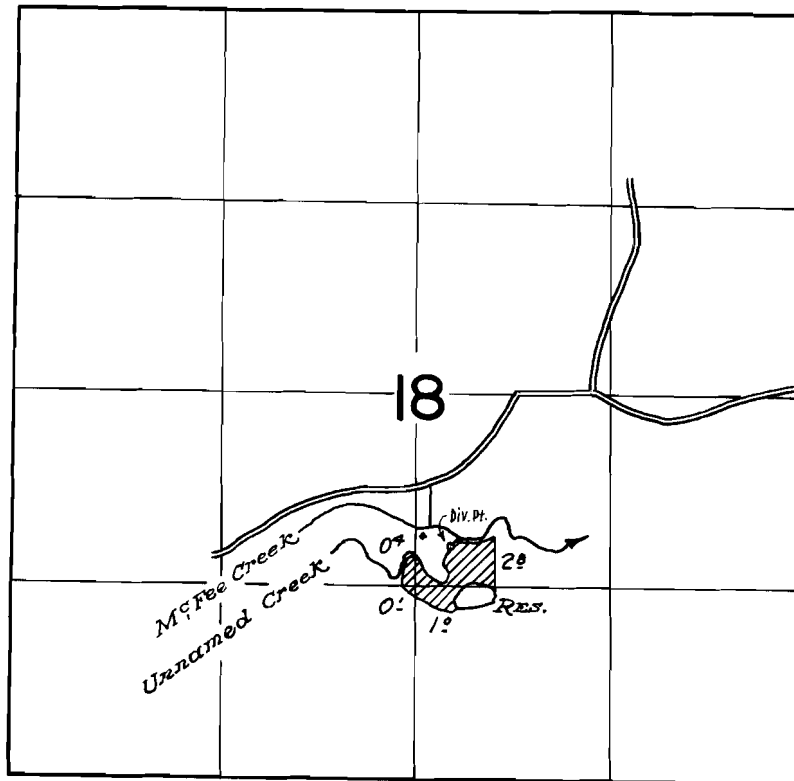

FINAL PROOF SURVEY
UNDER

Application No. R-31958 31959 Permit No. R-2094 25211
IN NAME OF

JAMES H. PATTERSON

Surveyed May 27, 1960, by