


T.5 S.R.3 W.W.M.

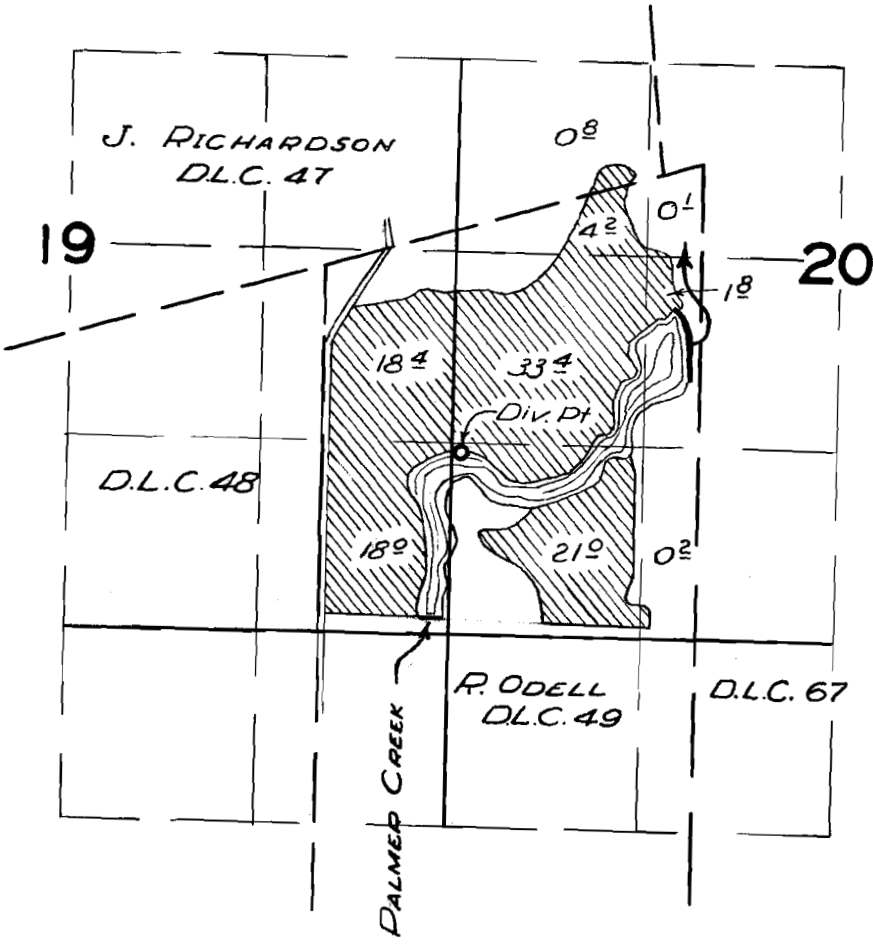

FINAL PROOF SURVEY UNDER

Application No. 25503 Permit No. 24405
P-25502 P-1905
IN NAME OF

CHARLES & ALICE STEPHENS

Surveyed 2 JUNE 1960 by M. Bish