T.4 S.R.4 W.W.M.

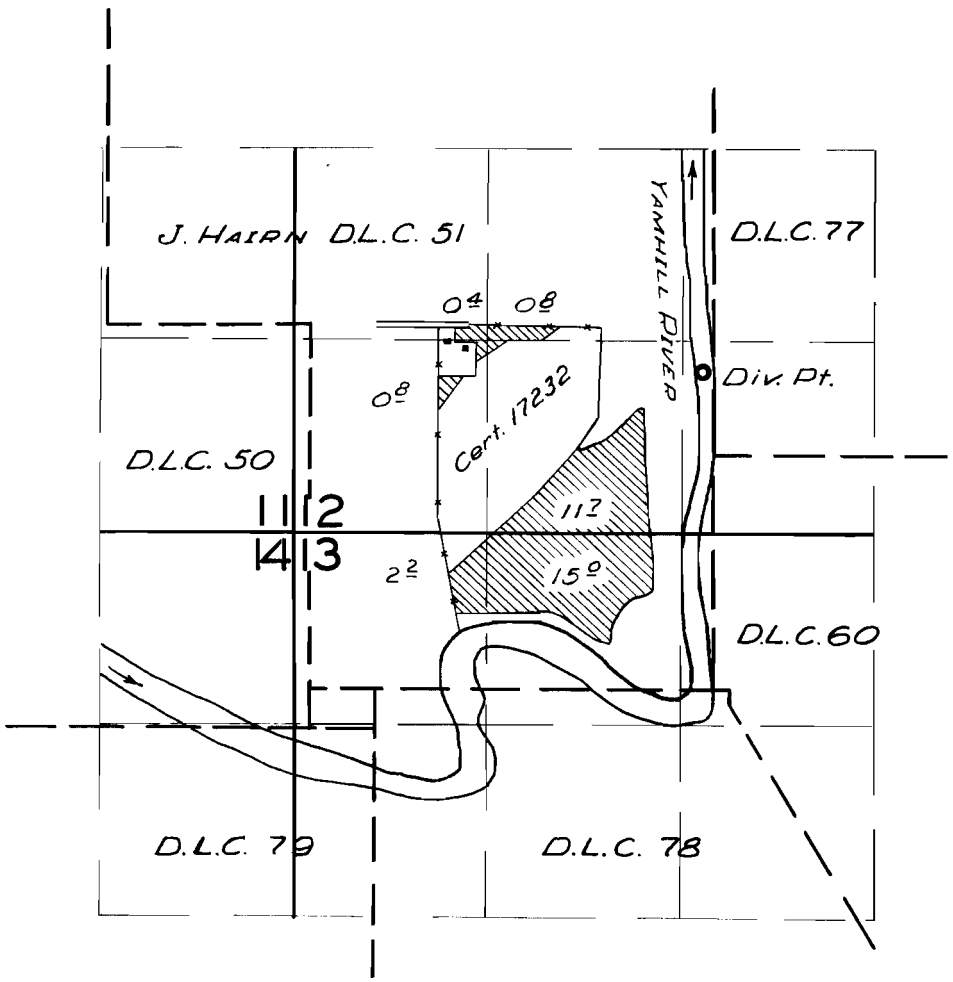

FINAL PROOF SURVEY
UNDER

Application No. 32170 Permit No. 25381
IN NAME OF

E.R. or GLADYS MORSS and R.D. REYNOLDS

Surveyed 31 May 1960, by Wm. Bish

DFQ-3D-139