


26

Tp. 14 S. R. 10 E.

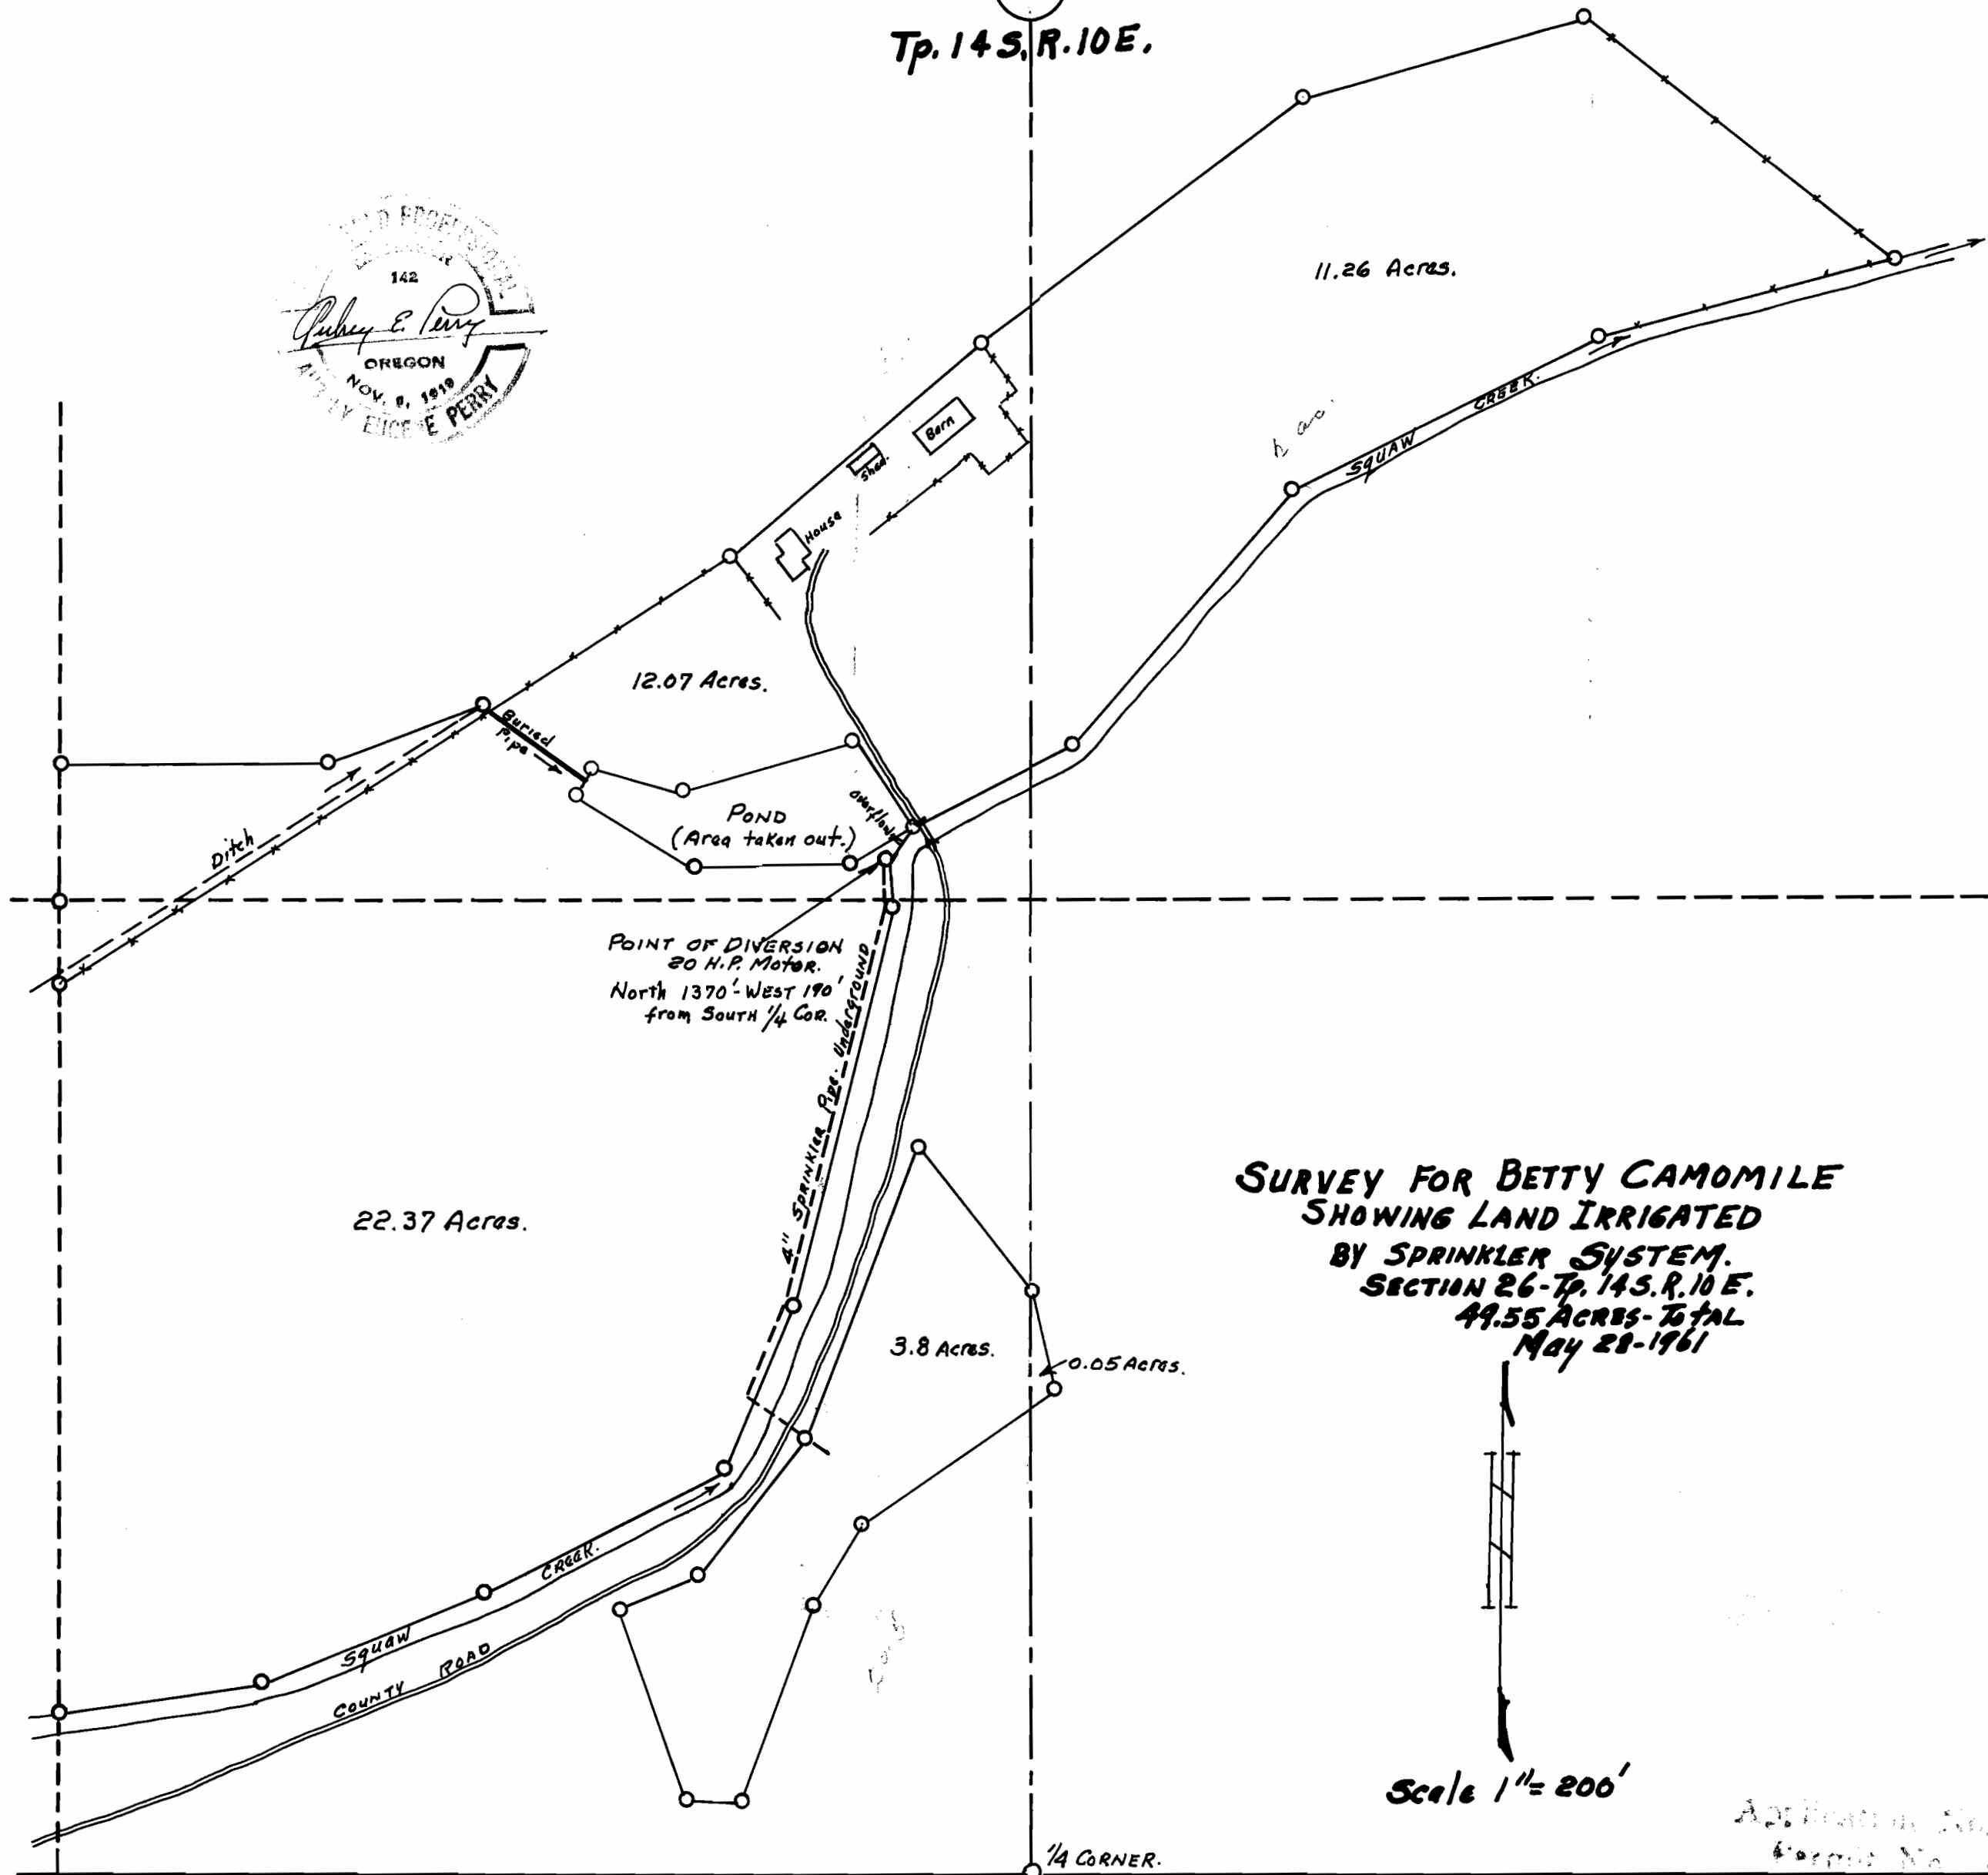

11.26 Acres.

12.07 Acres.

22.37 Acres.

3.8 Acres.

0.05 Acres.

POINT OF DIVERSION
20 H.P. Motor.
North 1370' West 190'
from South 1/4 Cor.

**SURVEY FOR BETTY CAMOMILE
SHOWING LAND IRRIGATED
BY SPRINKLER SYSTEM.
SECTION 26-Tp. 14 S. R. 10 E.
49.55 ACRES-TOTAL
May 28-1961**

Scale 1" = 200'

App. No. 34969
Permit No. 27307

1/4 CORNER.