


T. 9S. R. 40E. W.M.

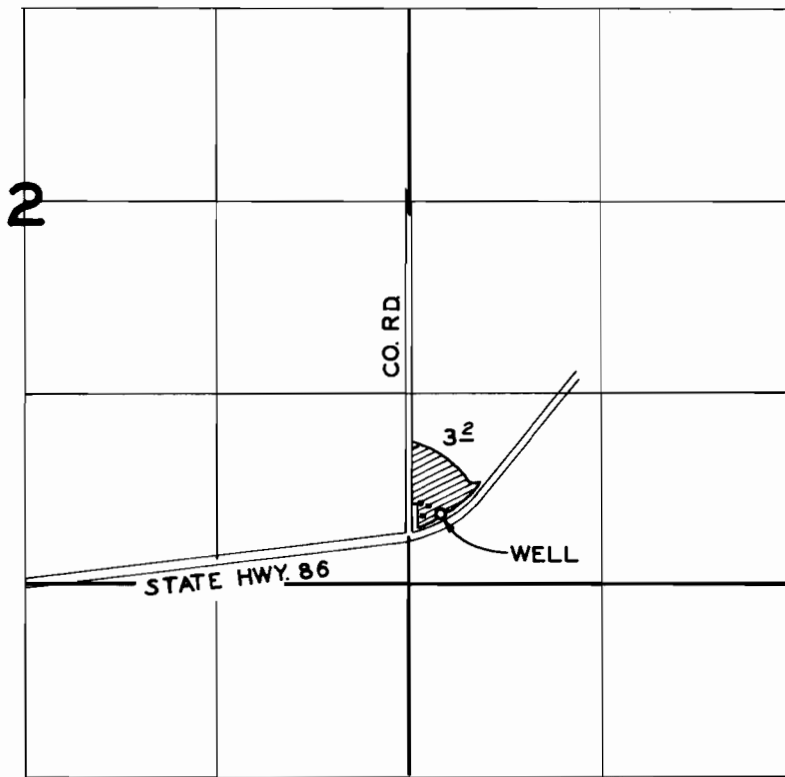

FINAL PROOF SURVEY
UNDER

Application No. G.287..... Permit No. G.206.....
IN NAME OF

ARLIE PATTON

Surveyed SEPT. 19 1960., by R. H. JACKSON