


T.11-12 S.R.4 3 E.W.M.

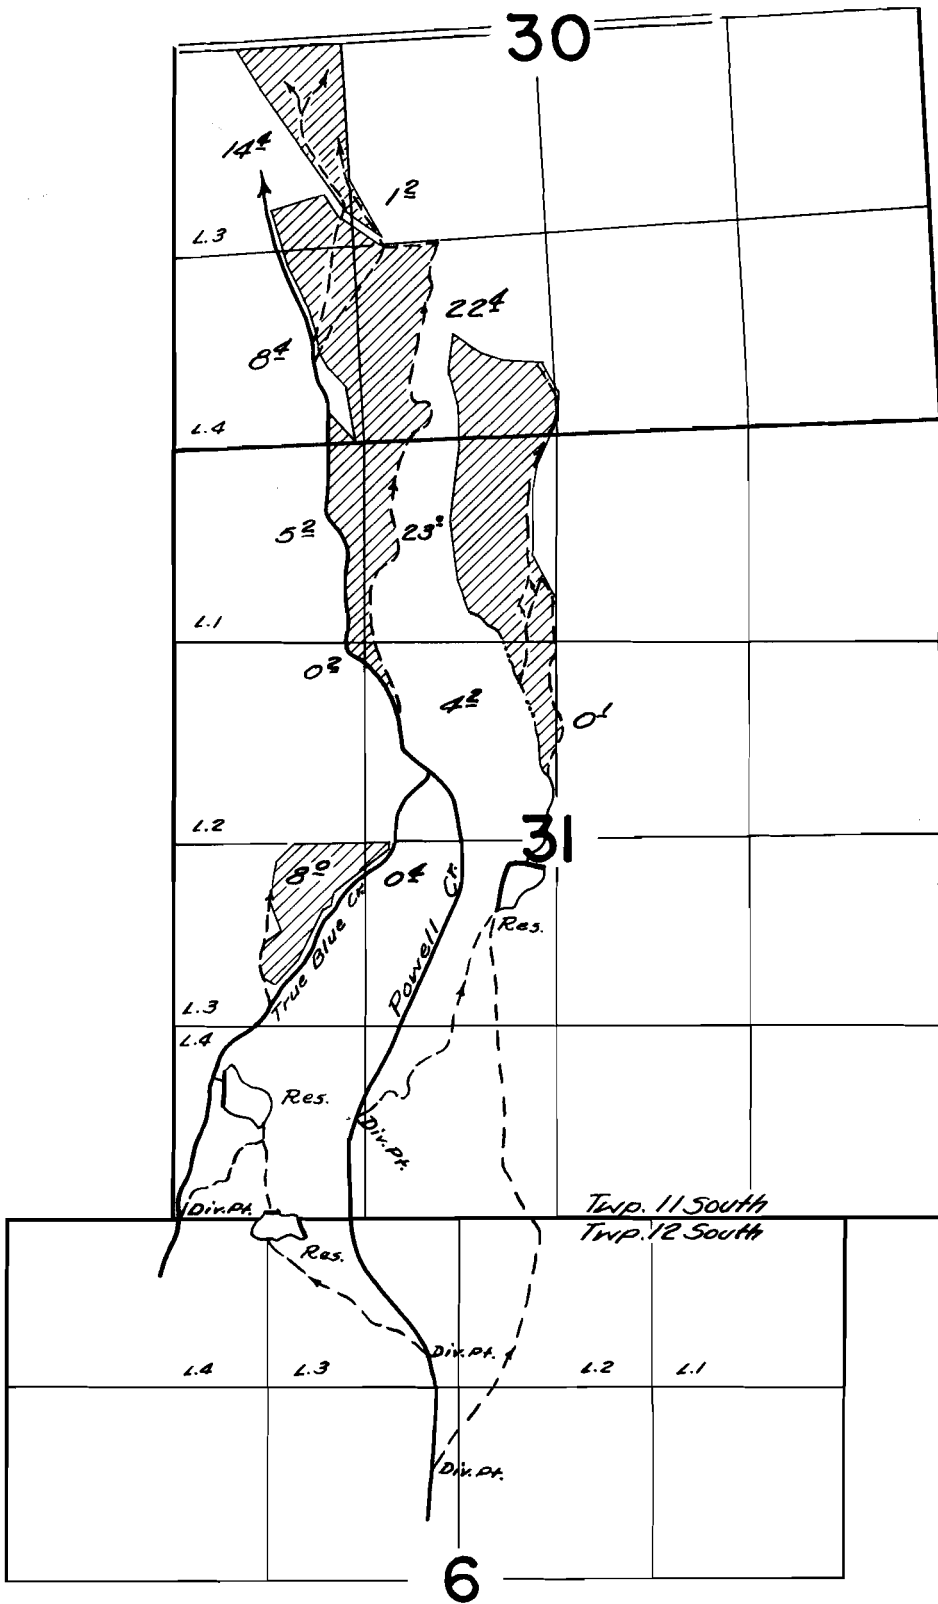

FINAL PROOF SURVEY

UNDER

Application No. R-20548 20549 R-808 16116

IN FAVOR OF

A. T. CUTTING

Surveyed Sept. 15, 1960, by C. O. Butts