


T.7S.R.39E.W.M.

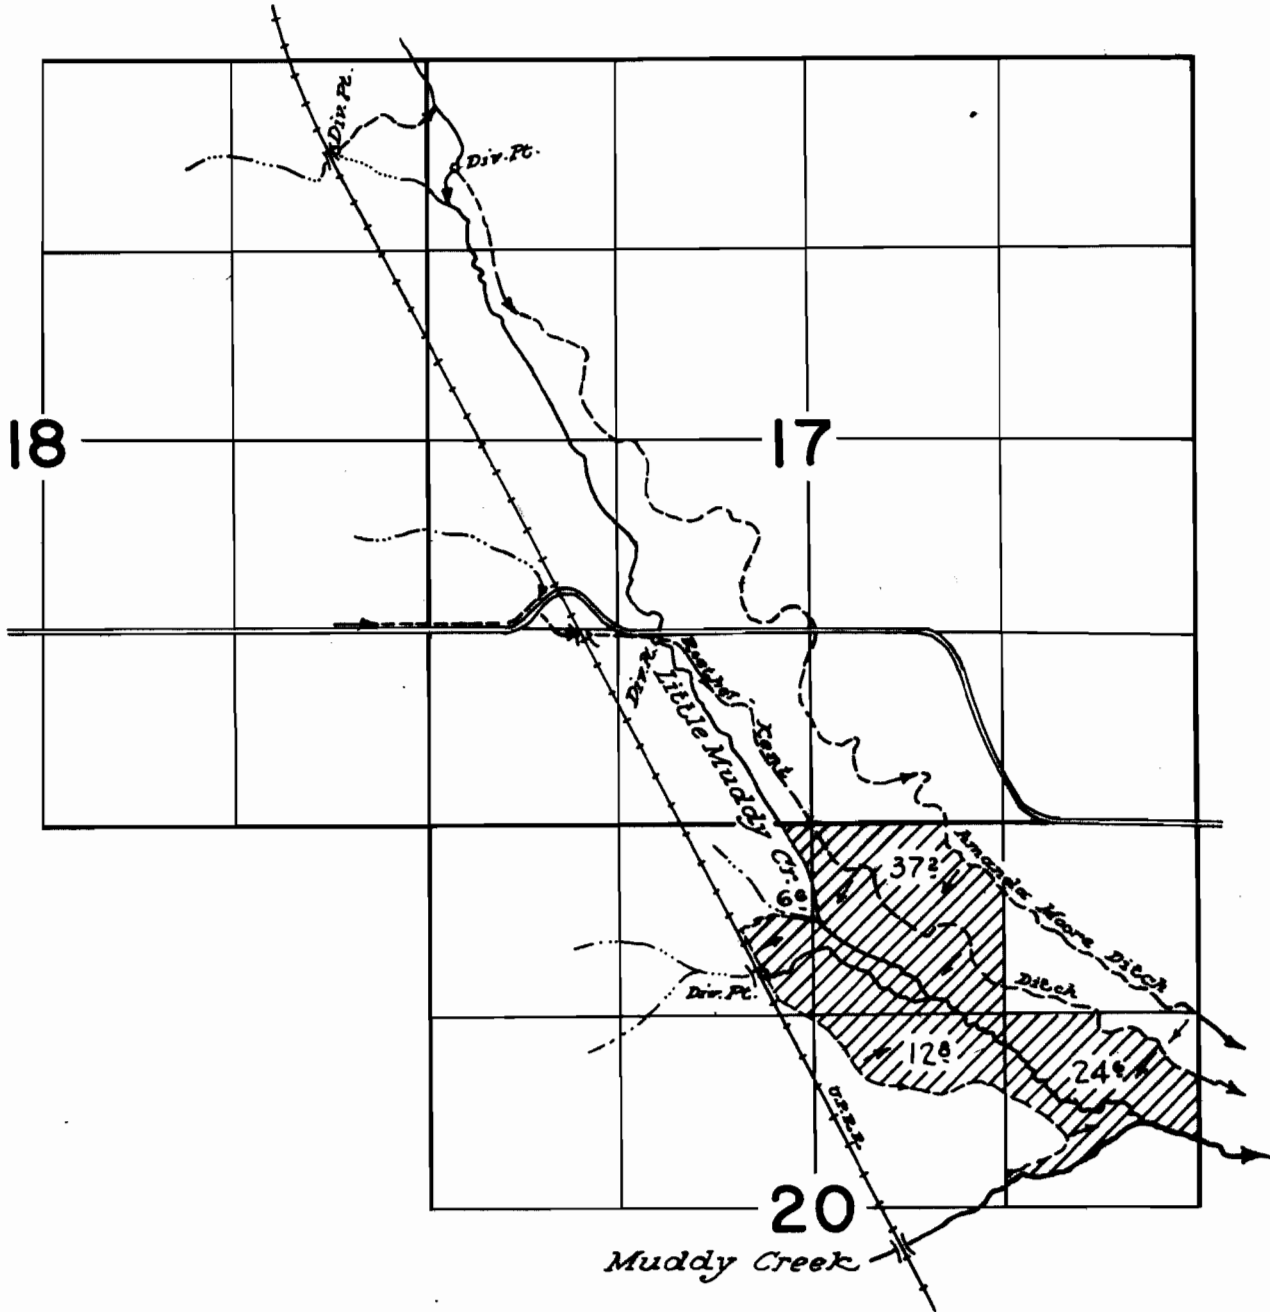

**FINAL PROOF SURVEY**  
UNDER

Application No. 22073... Permit No. 17526...  
IN NAME OF

**ORVILLE FISHER**

Surveyed Sept. 17 1960, by *Alston*