


T. 7S. R. 46&47E. W. W.

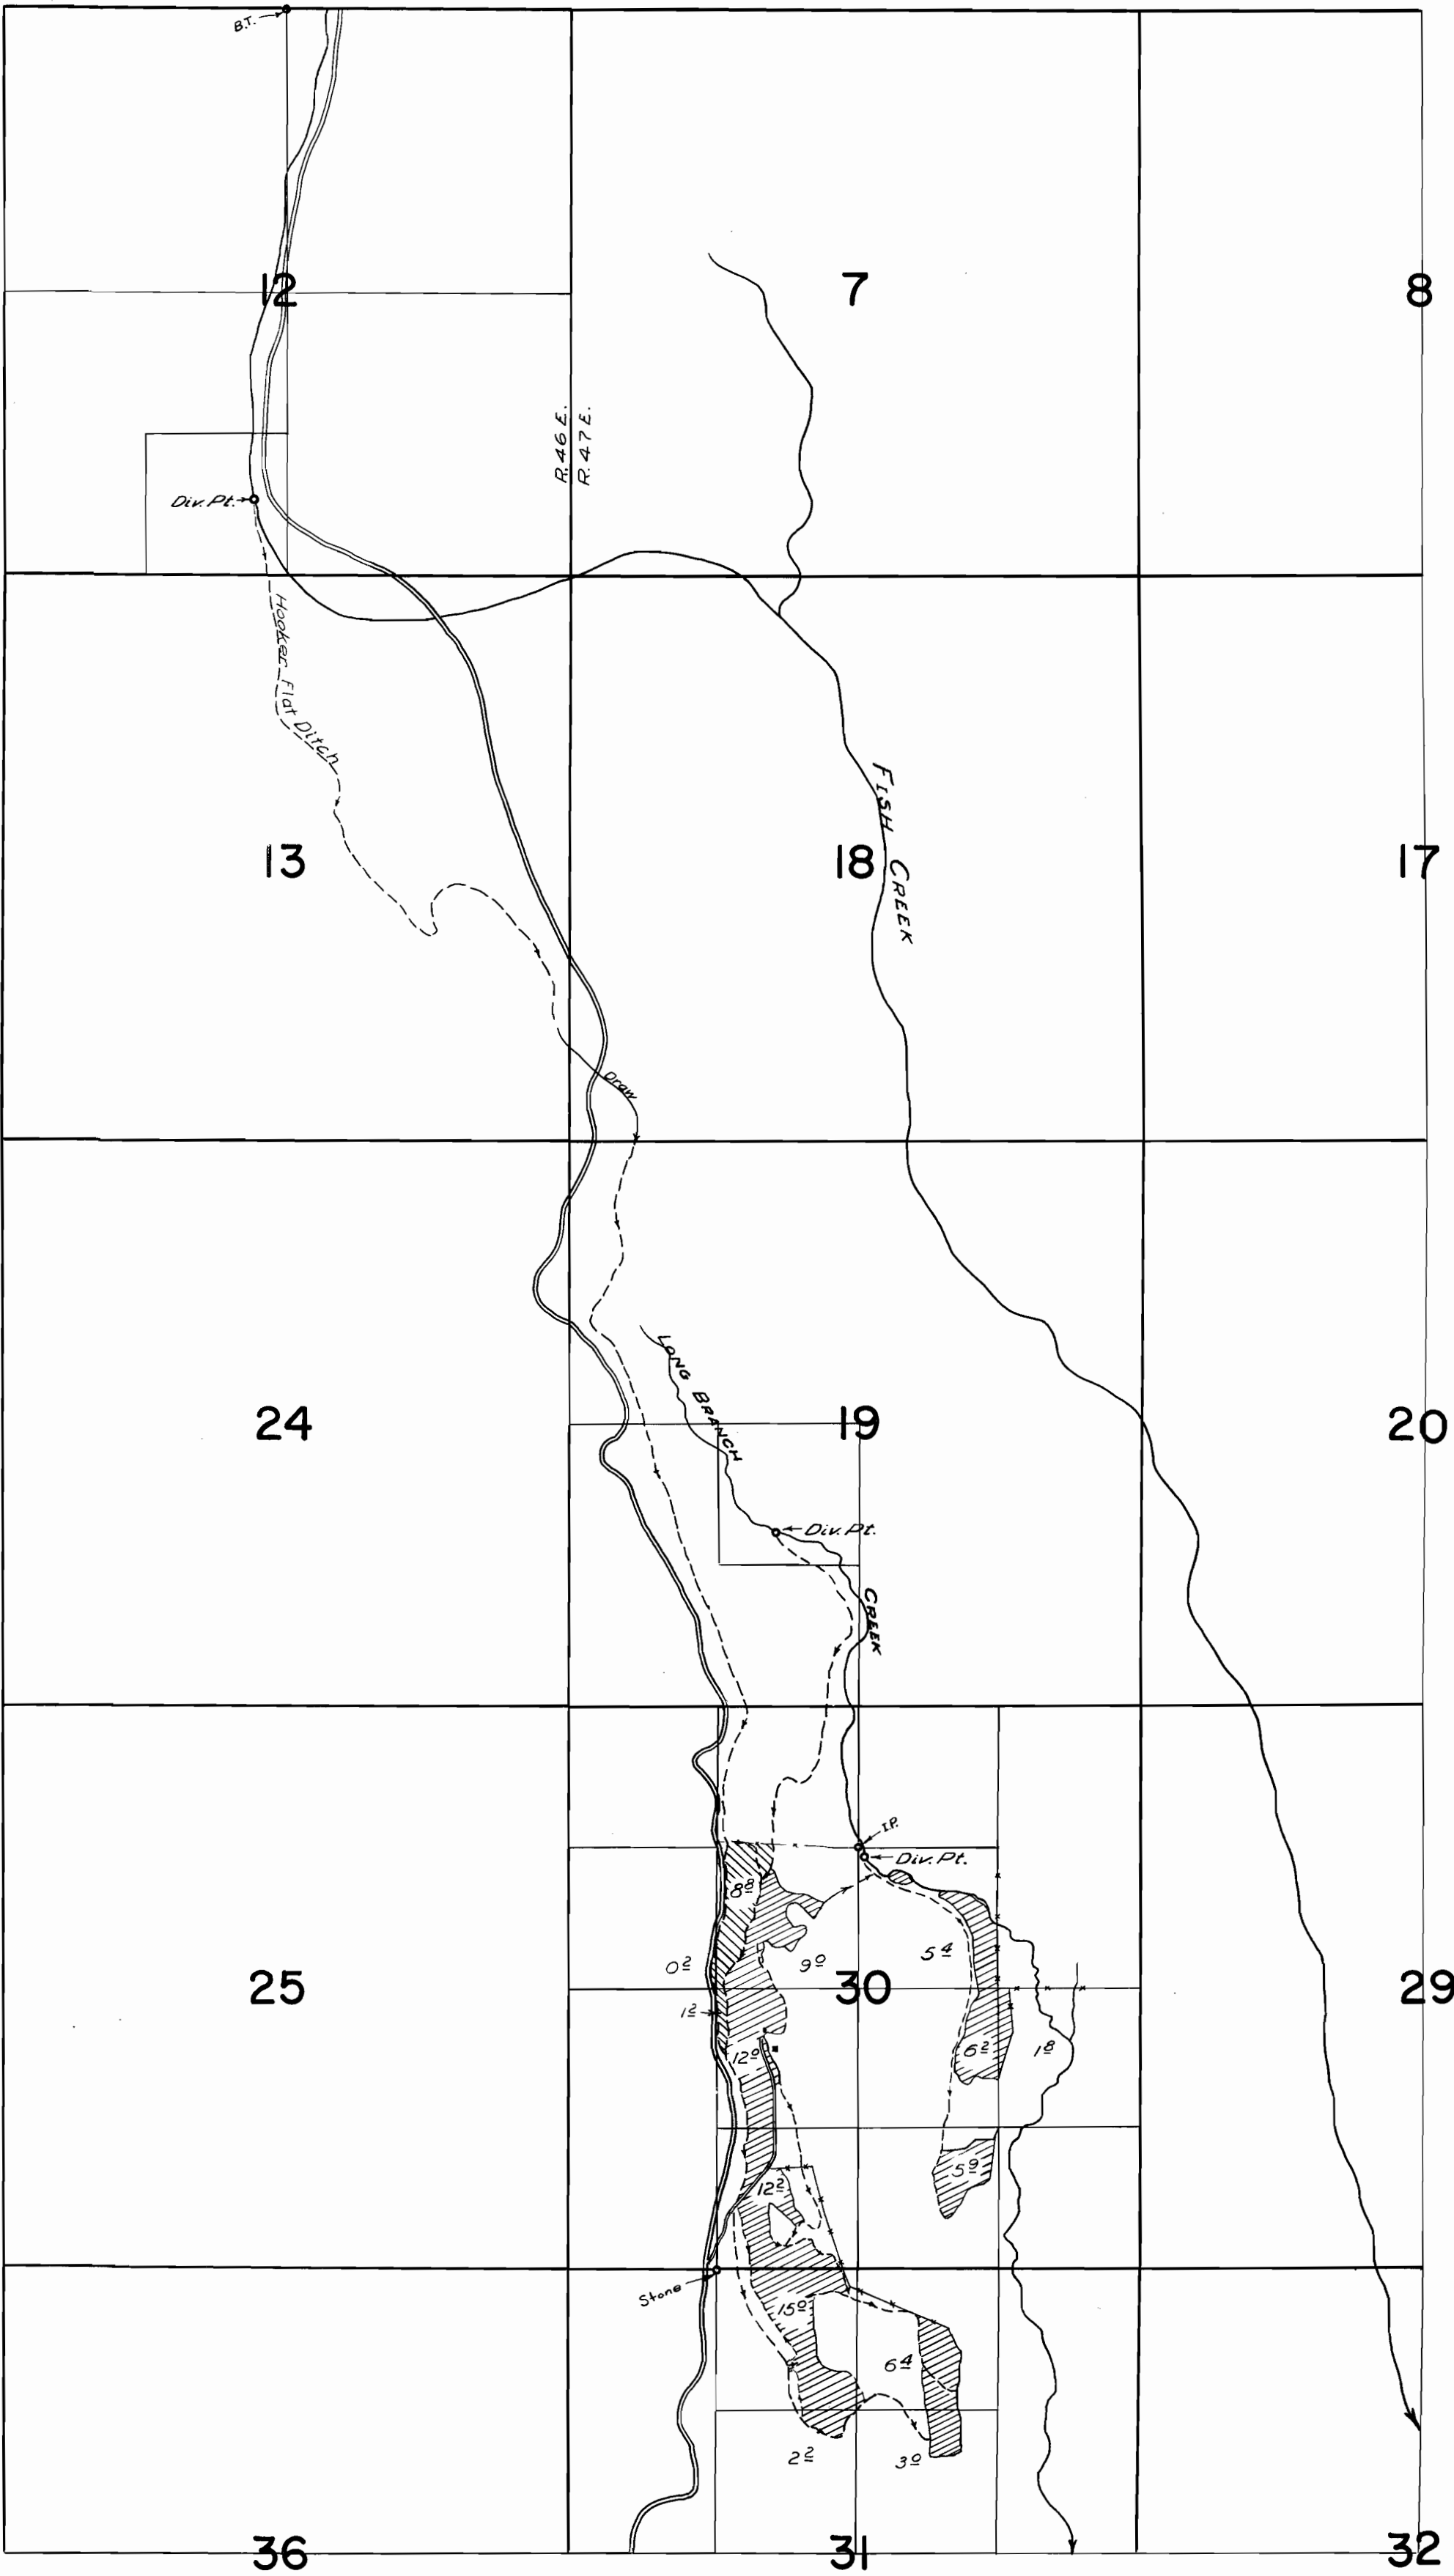

FINAL PROOF SURVEY
UNDER

Application No. 22616 Permit No. 17897
24830 19673
IN NAME OF

J. V. THOMAS

Surveyed 14 Sept. 1960 by *M. Bish*