


T. 7 S. R. 46 & 47 E. W. W.

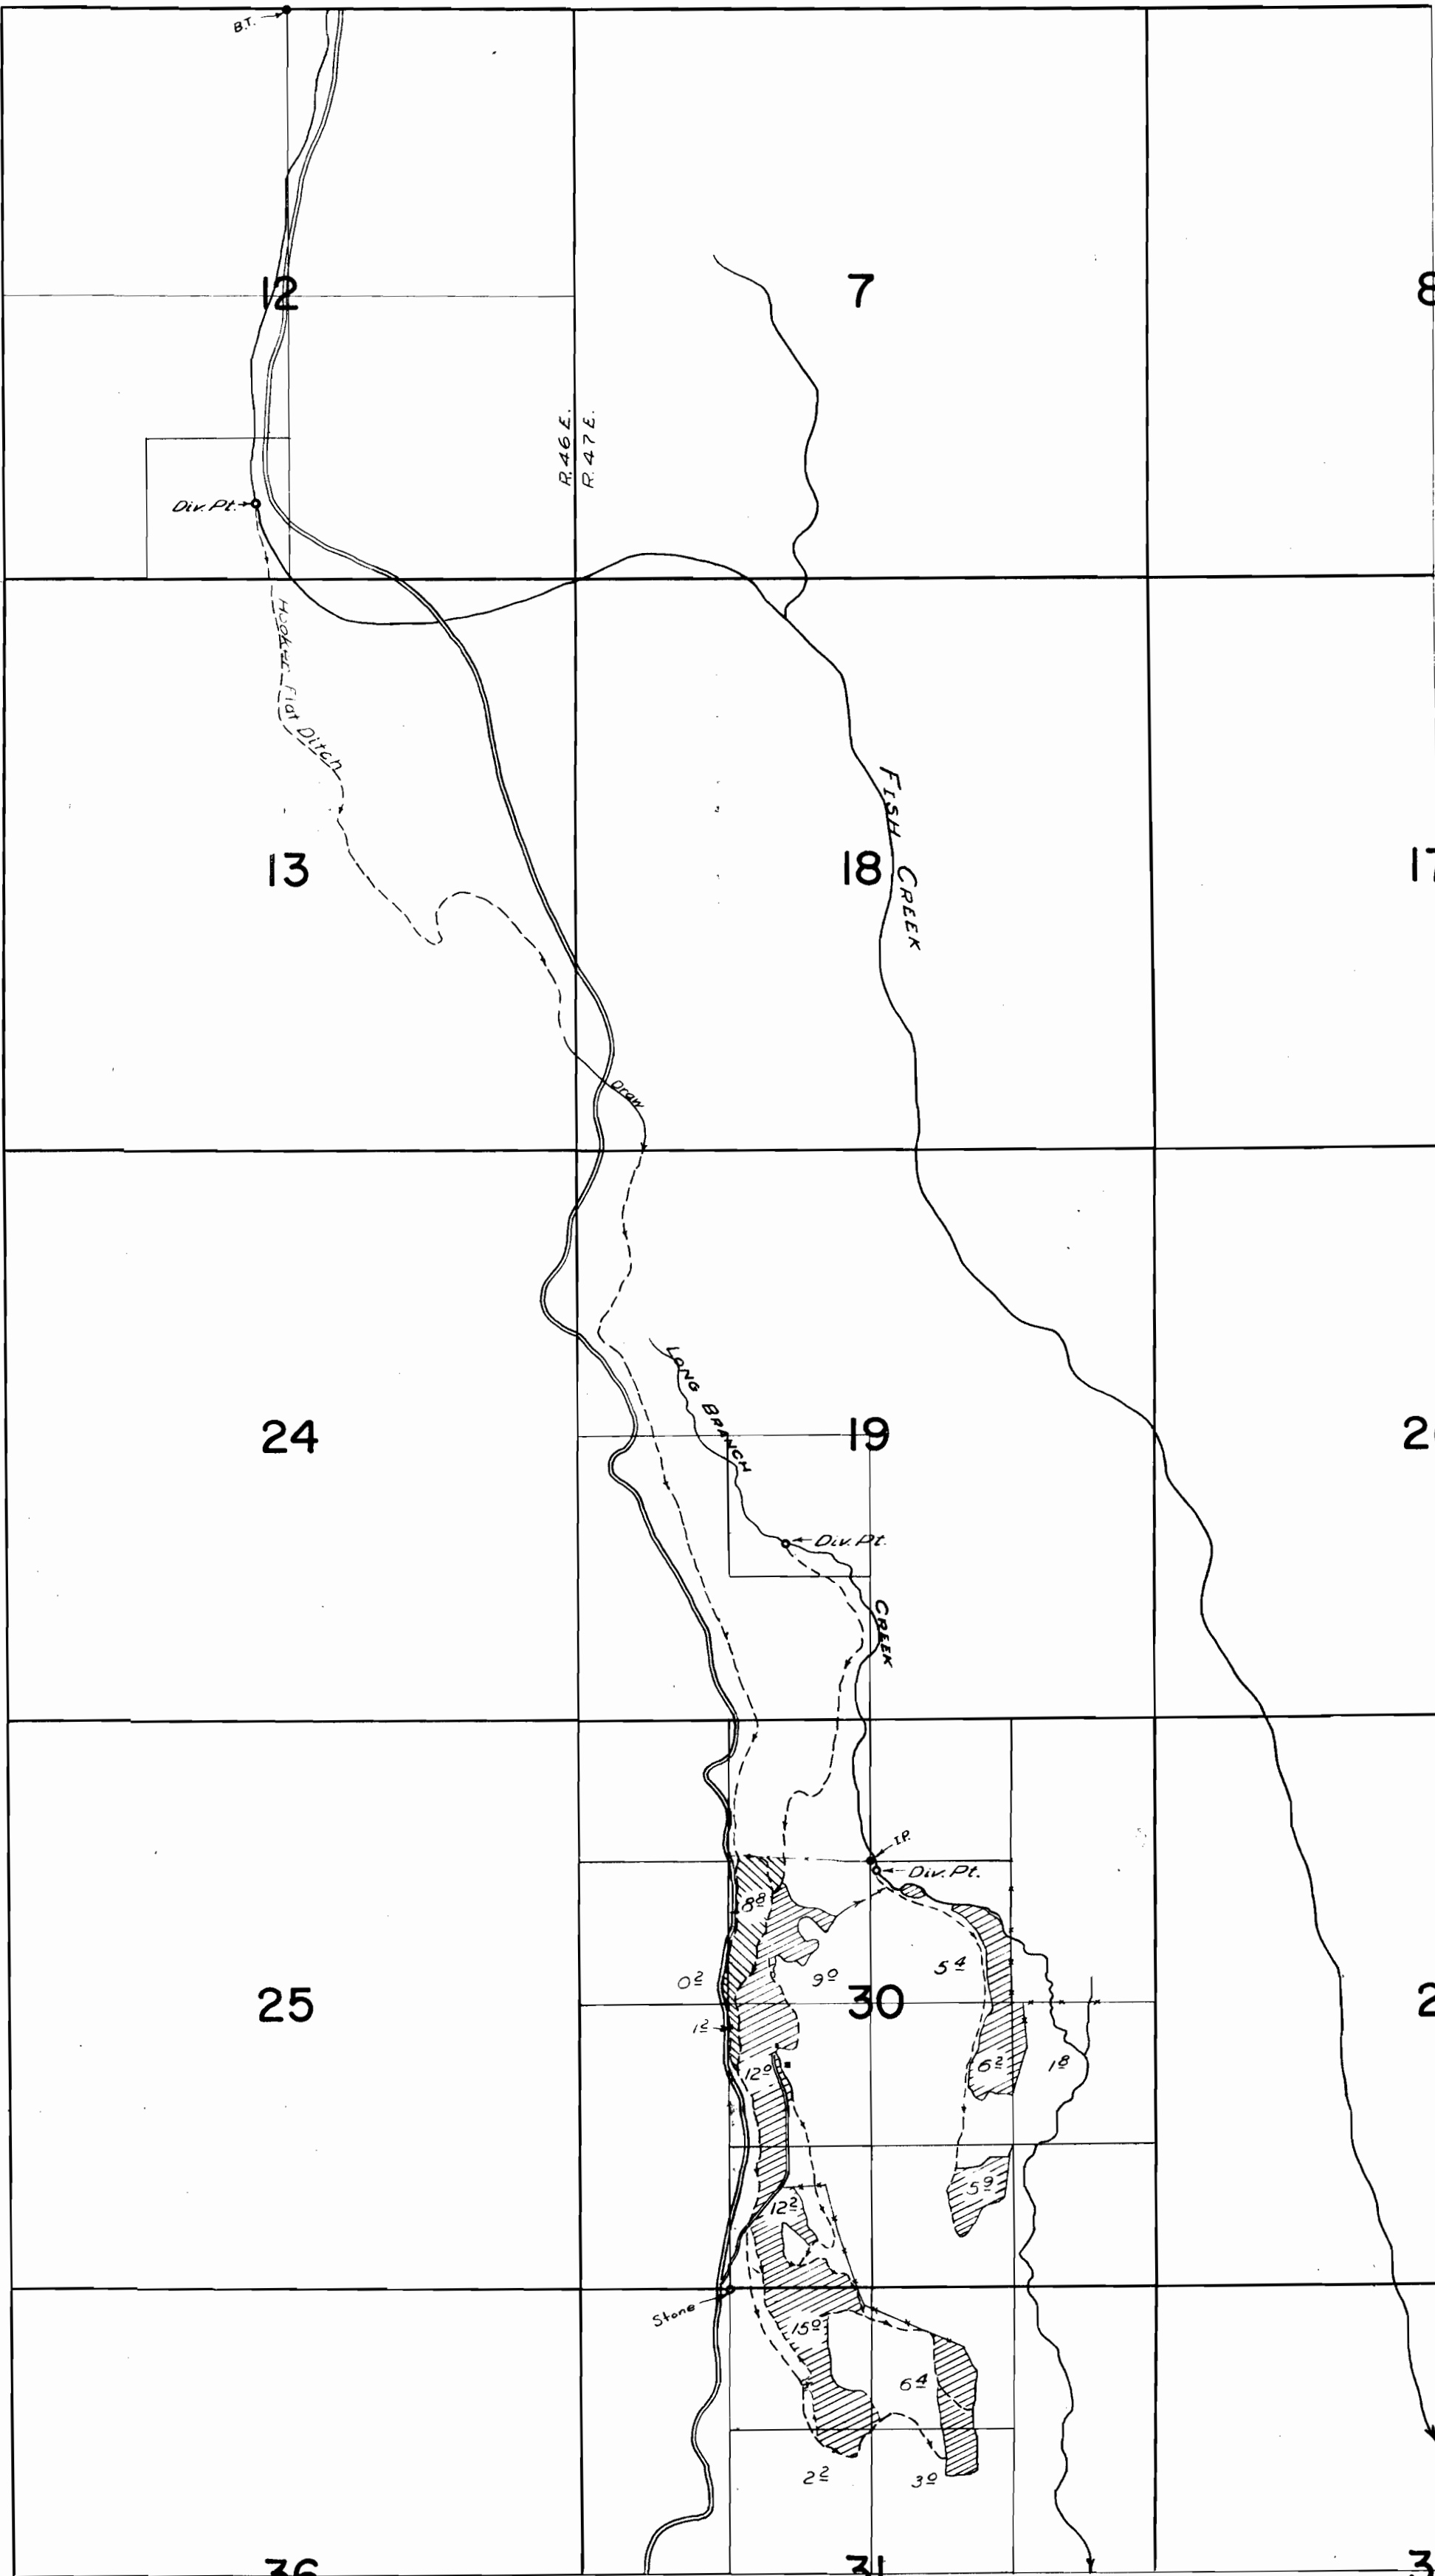

FINAL PROOF SURVEY

UNDER

Application No. 22616 Permit No. 17897
24830 19673
 IN NAME OF

J. V. THOMAS

Surveyed 14 Sept. 1960 by M. Bish.