


T.6S. R.38 E.W.M.

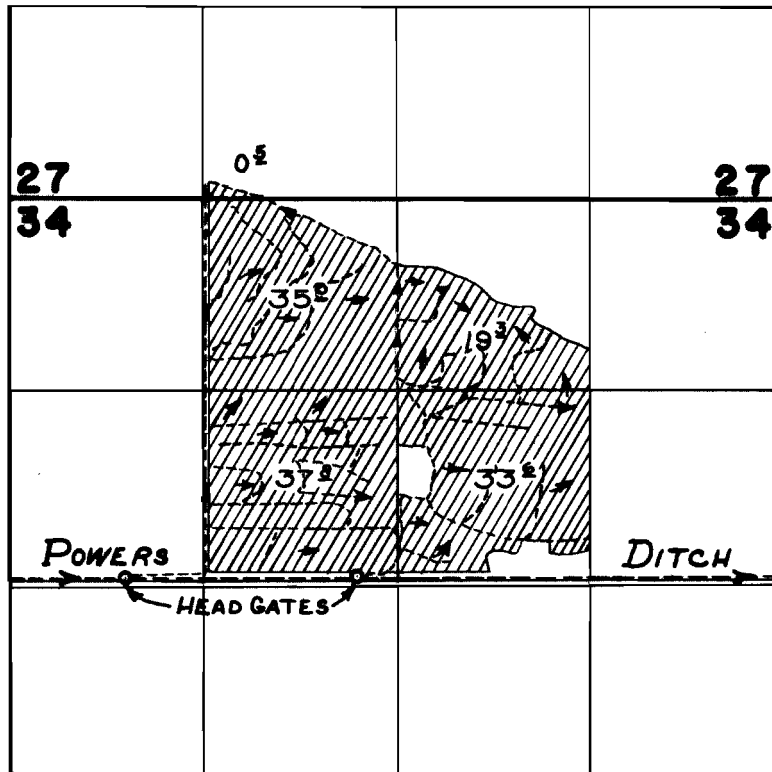

FINAL PROOF SURVEY
UNDER

Application No. 26827. Permit No. 21069.....
IN NAME OF

.....*WILLIAM O. & FAY CHRISTENSEN*.....

Surveyed *SEPT. 15* 1960, by *[Signature]*

BBB-3N-71