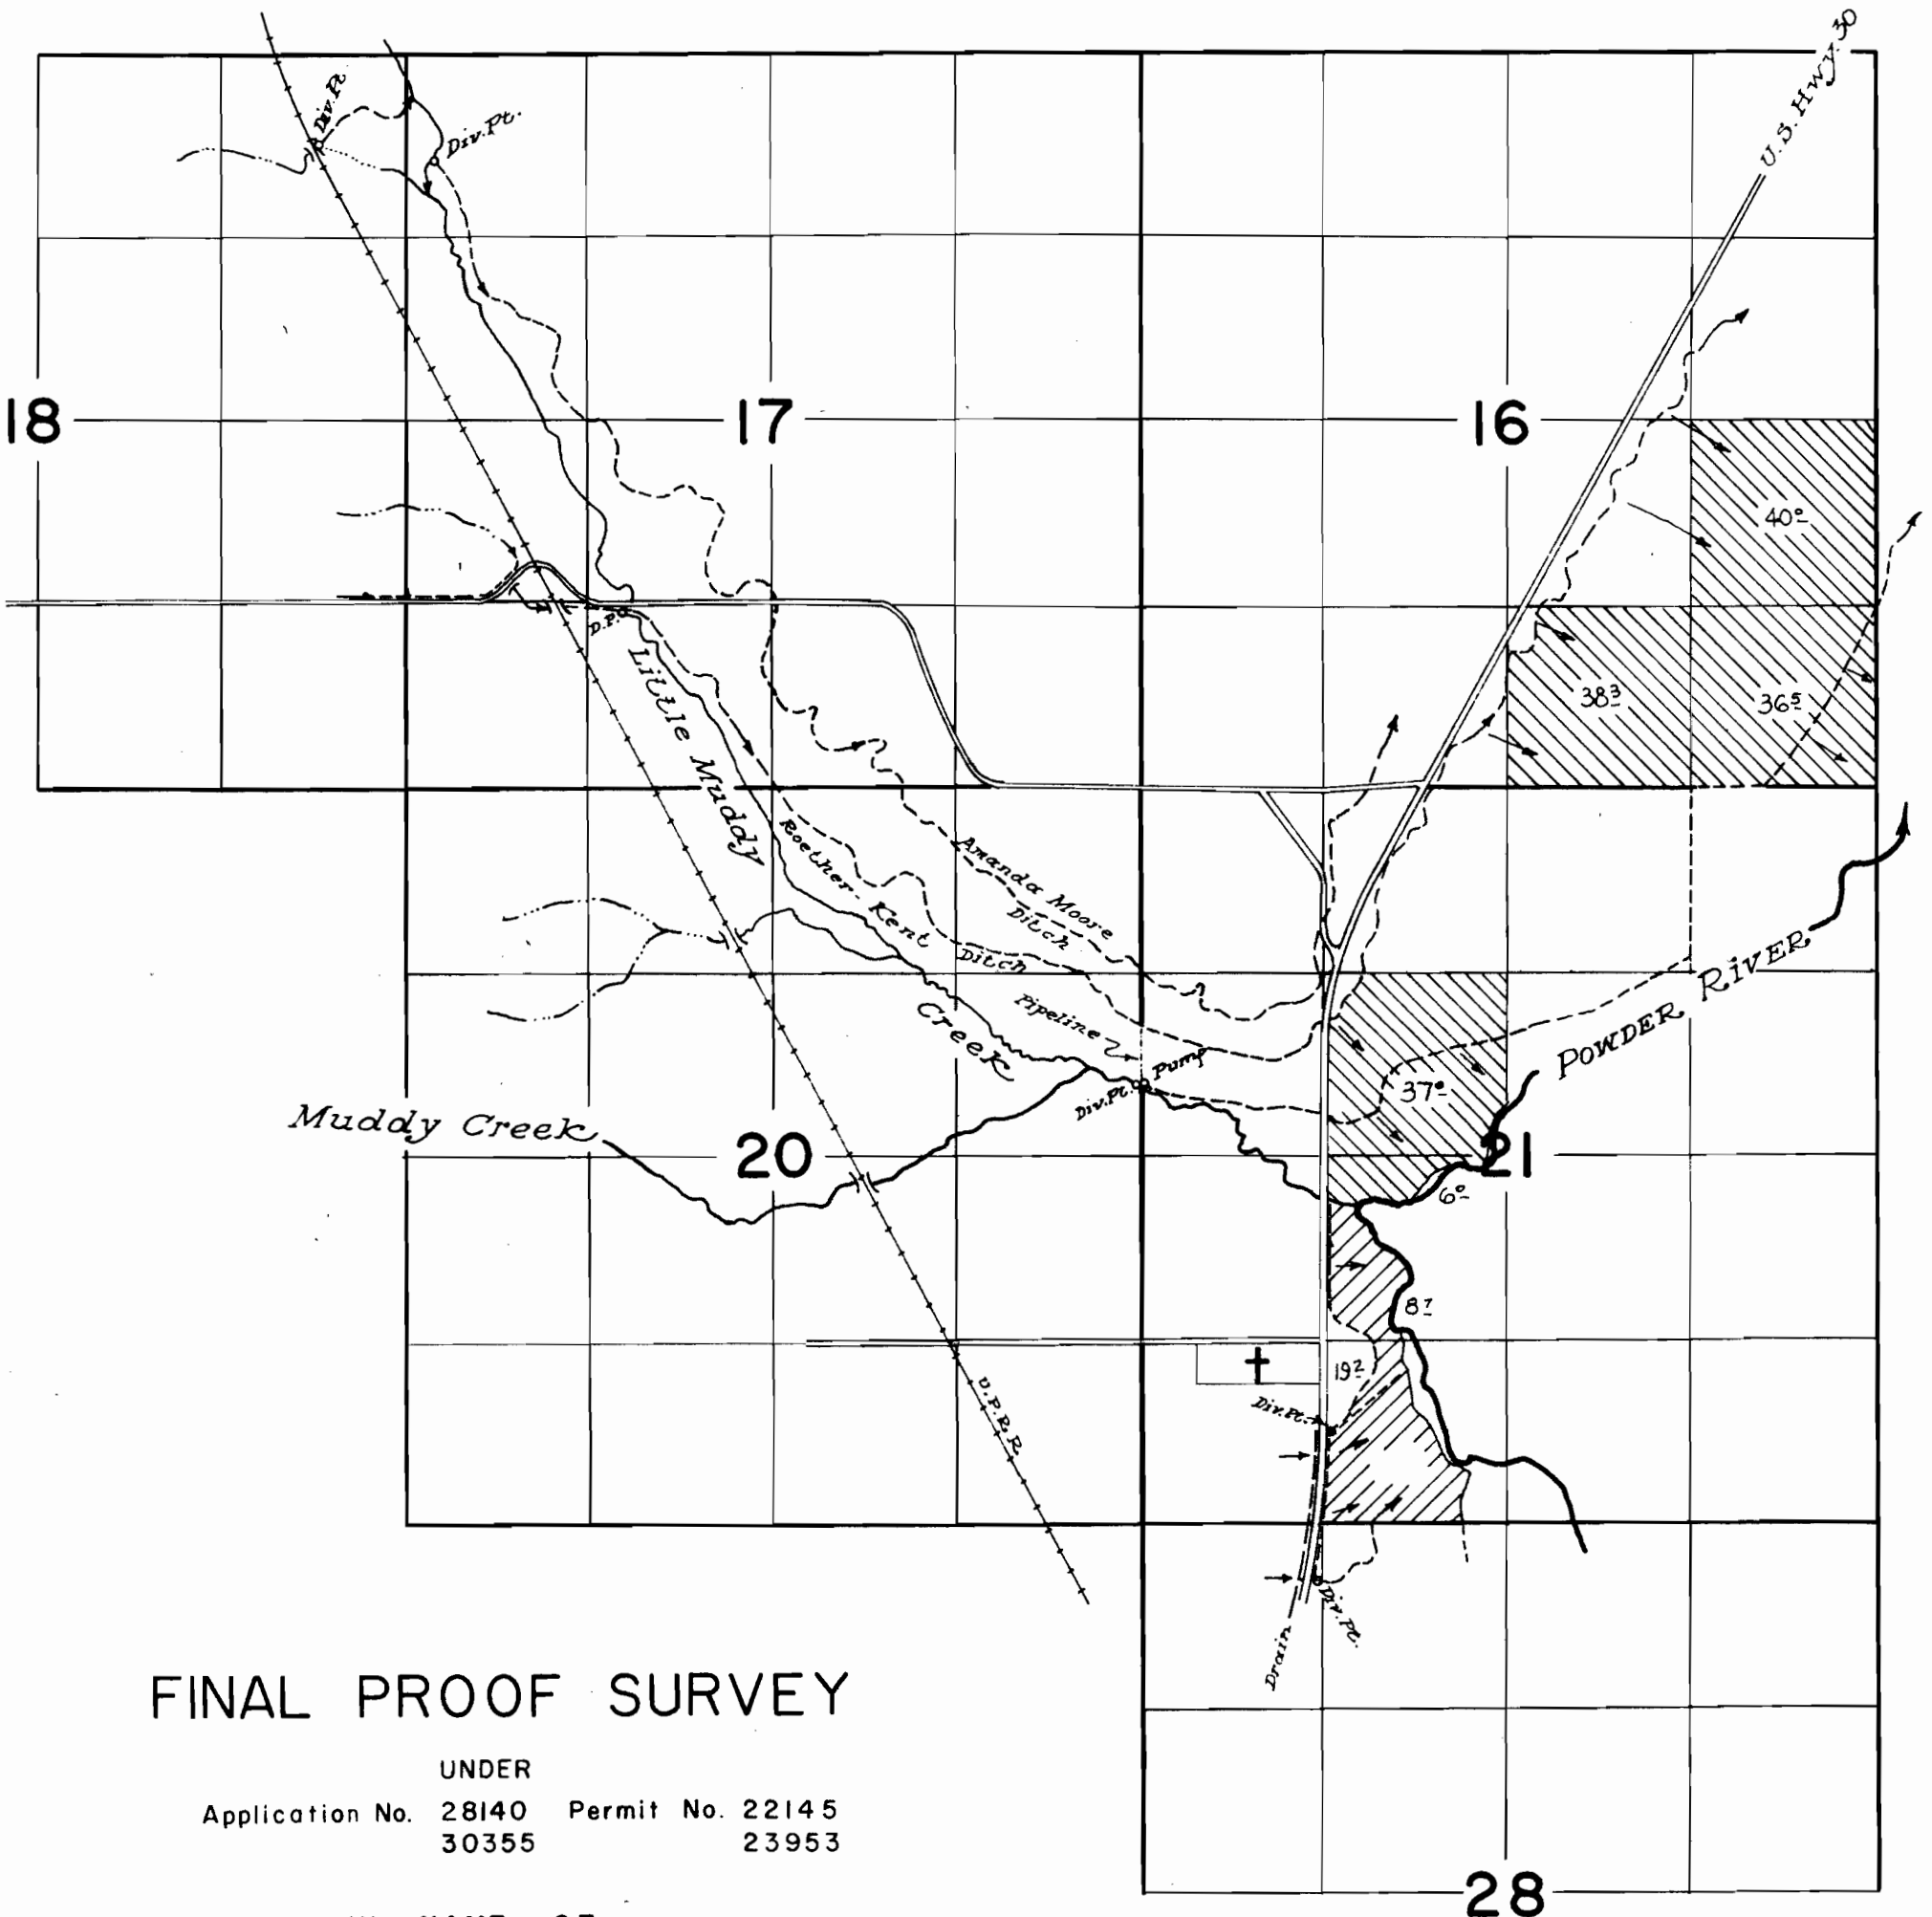


T.7S.R.39E.W.M.



FINAL PROOF SURVEY

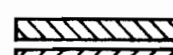
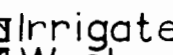
UNDER

Application No. 28140 Permit No. 22145
30355 23953

IN NAME OF

EDNA M. STEWART

Surveyed Sept. 17, 1960 by *A. Jackson*

 Irrigated from Muddy Creek
 Waste-water irrigated