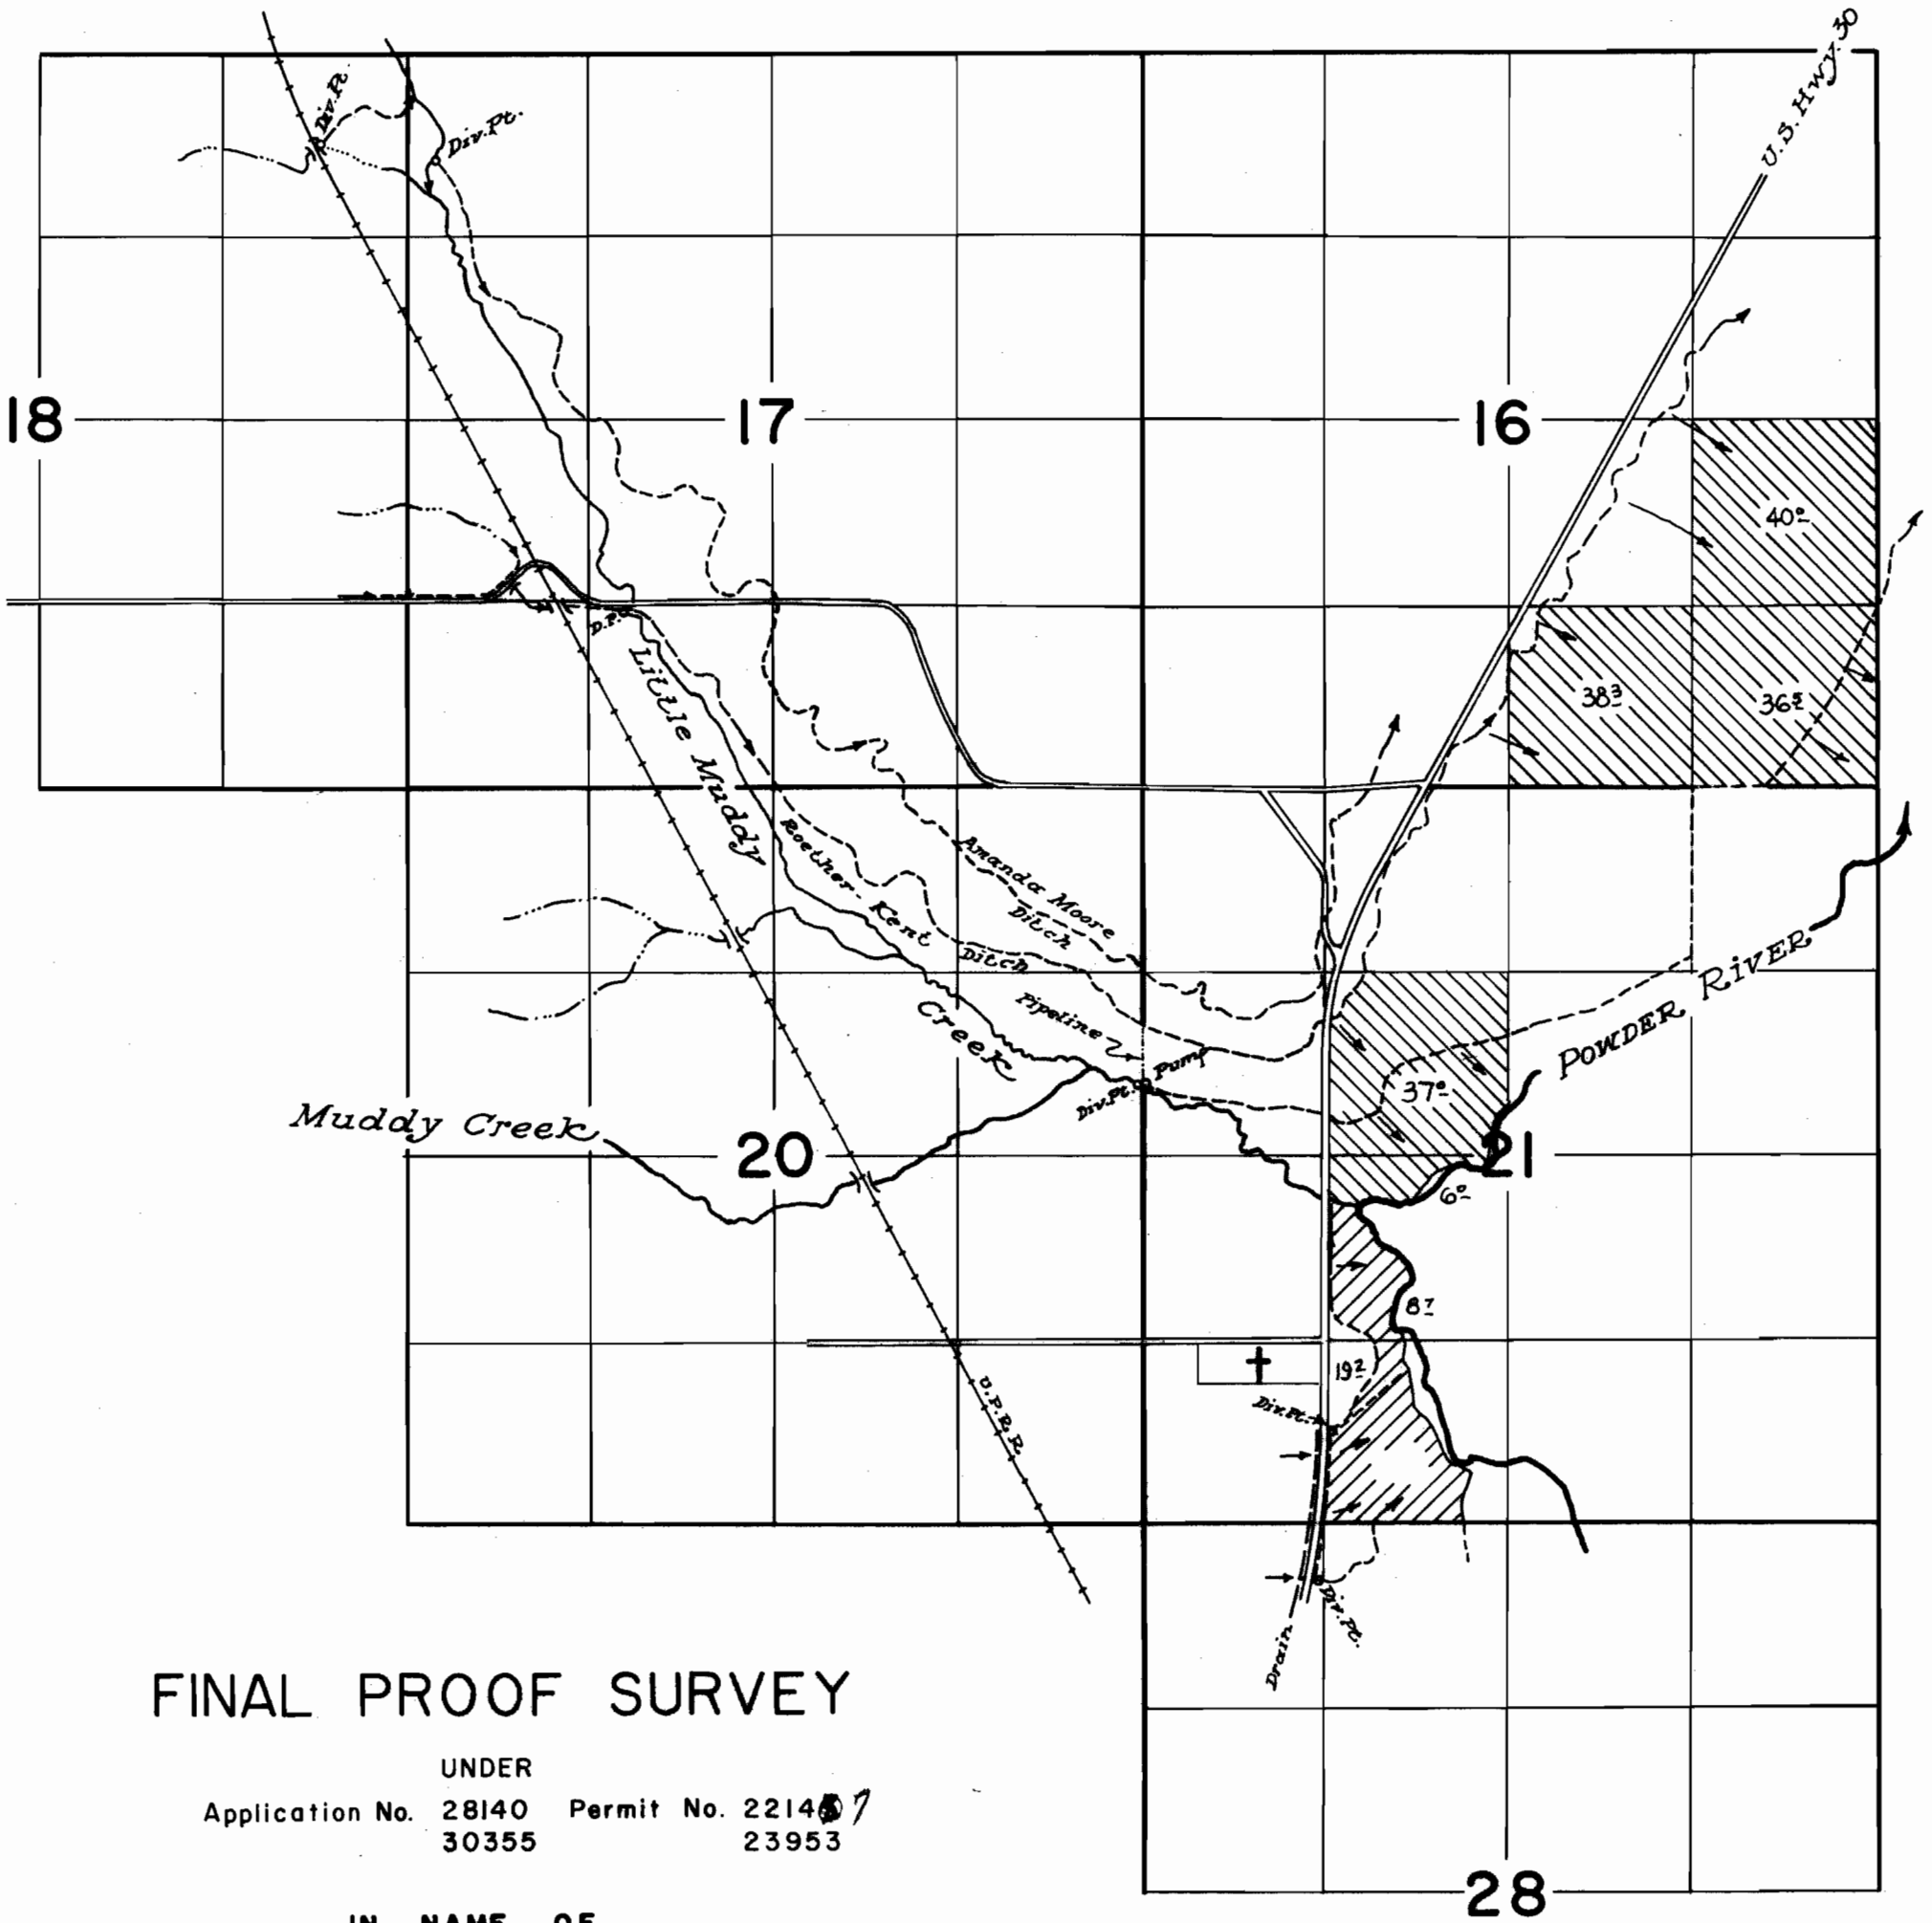


T.7S.R.39E.W.M.


 


FINAL PROOF SURVEY

UNDER  
 Application No. 28140 Permit No. 221457  
 30355 23953

IN NAME OF  
 EDNA M. STEWART

Surveyed Sept. 17, 1960 by *R. Jackson*

 Irrigated from Muddy Creek  
 Waste-water irrigated