


T.7S.R.41E.W.M.

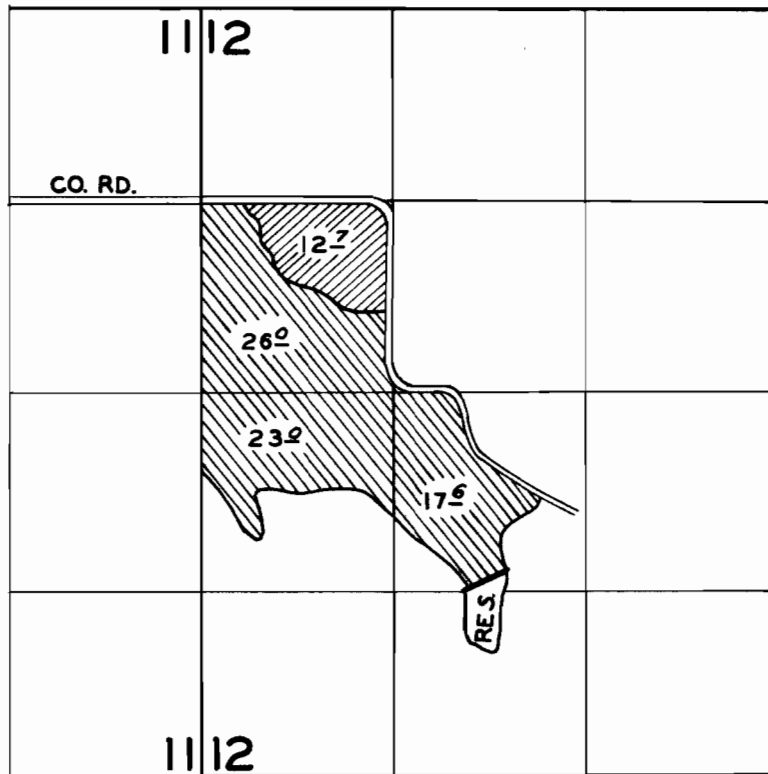

FINAL PROOF SURVEY UNDER

PRIMARY  SUPPL. 

Application No. ^{R30103} 30105 Permit No. ^{R1989} 24711
IN NAME OF

LEWIS H. & JOE H. WIRTH

Surveyed SEPT. 14, 1960, by R.H. JACKSON