


# T.7S.R.39 E.W.M.

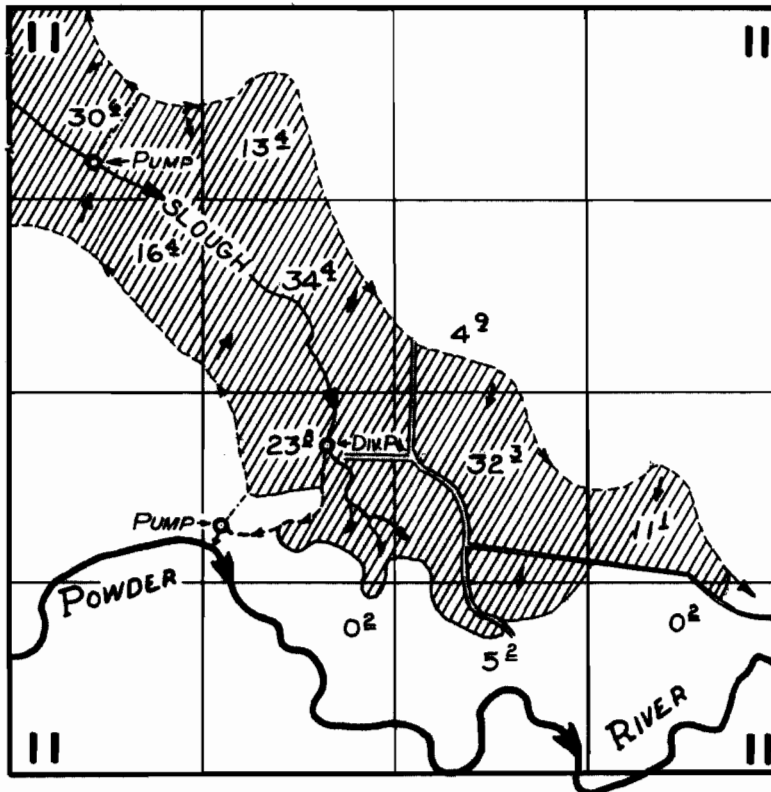

## FINAL PROOF SURVEY UNDER

Application No. 30209.. Permit No. 24712...  
IN NAME OF

.....*WALTER JACOBSON*.....

Surveyed SEPT. 16 1960, by *W. Jacobson*

*W. J.*