


T.8S.R.39E.W.M.

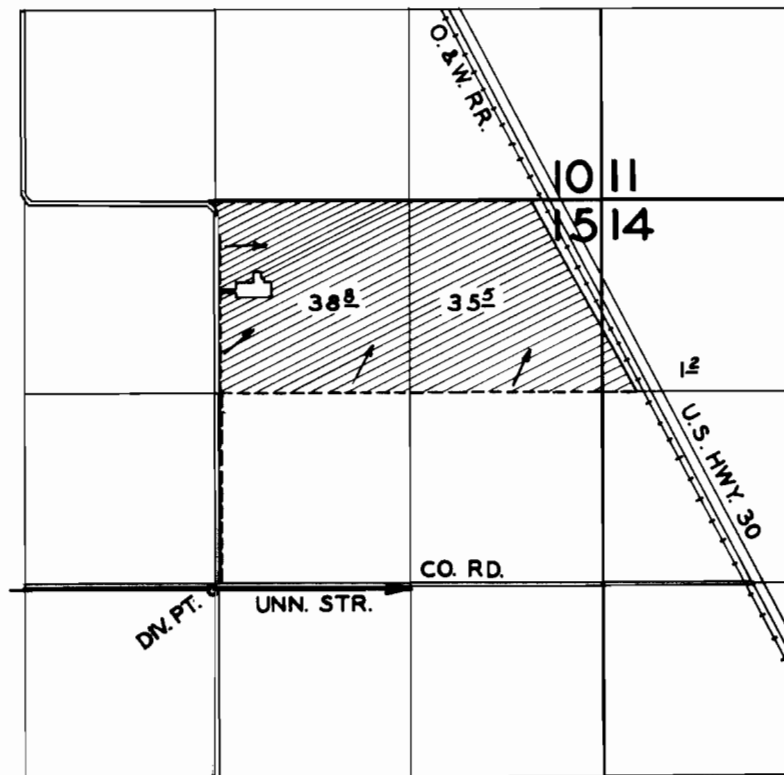

FINAL PROOF SURVEY
UNDER

Application No. 32600..... Permit No. 25990.....
IN NAME OF

J. E. YOUNG

Surveyed SEPT. 19. 19.60., by R.H. JACKSON.....