


# T.11S.R.4W.W.M.

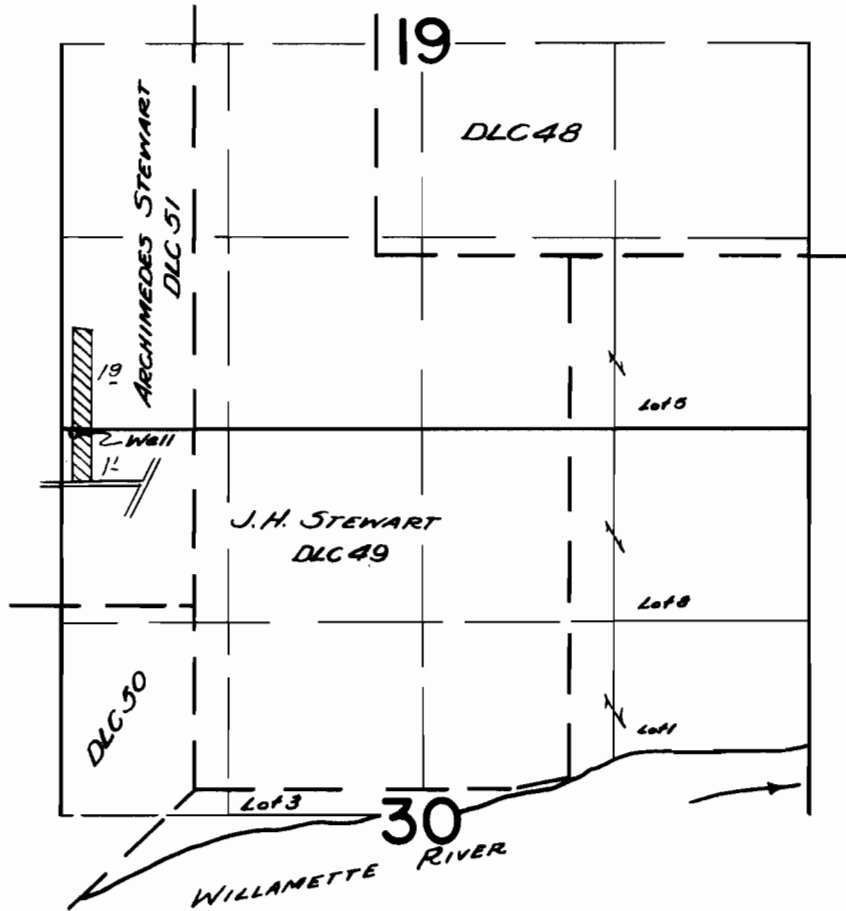

## FINAL PROOF SURVEY UNDER

Application No. G-783 Permit No. G-724  
IN NAME OF

H. E. DUNSMOOR

Surveyed March 10 1959, by R. H. Jackson