


T.12S.R.4W.W.M.

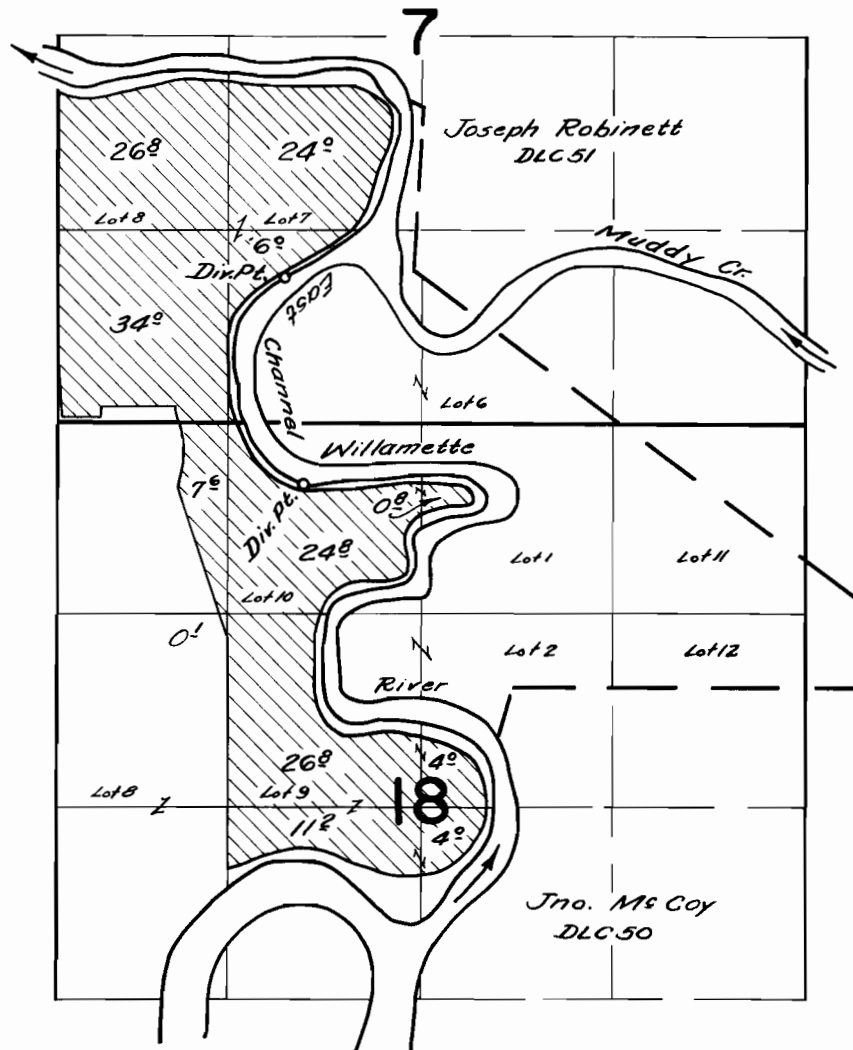

FINAL PROOF SURVEY UNDER

Application No. 32457 Permit No. 25673
IN NAME OF

THEL F. NEVILLE

Surveyed Oct. 12, 1960, by *C. O. Burt*