


T.12S.R.6W.W.M.

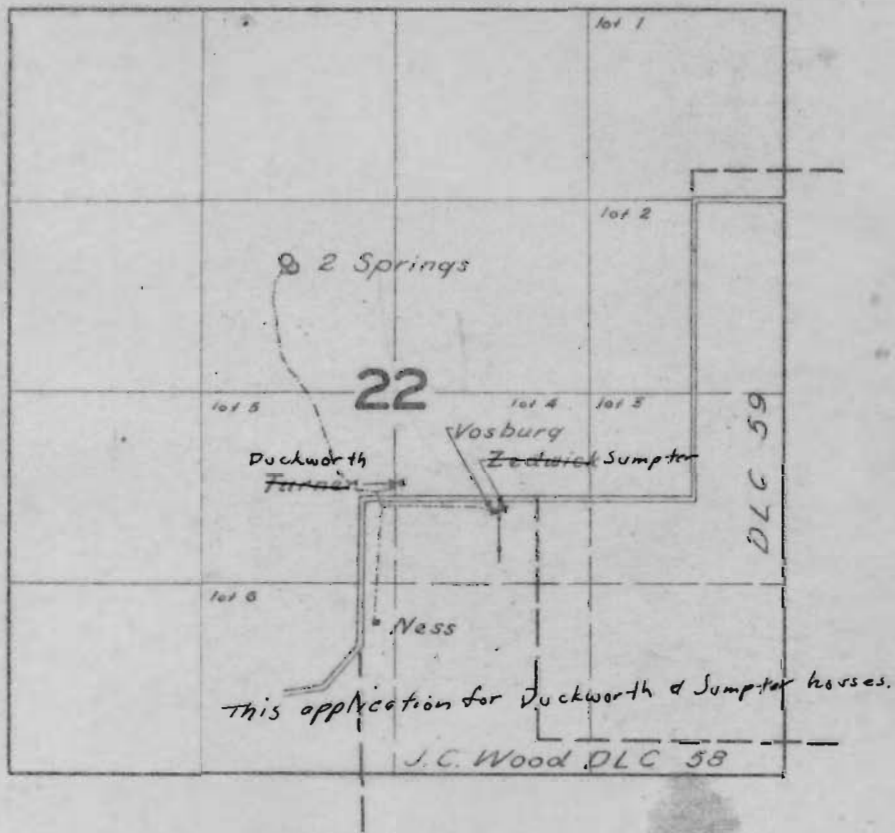

Ness & Vosburg houses under Permit 15947

FINAL PROOF SURVEY
UNDER

Application No. 20423 Permit No. 15947
IN NAME OF

HENRY M. NESS

Surveyed 19 Aug. 1957, by *C. A. Kelley*

Application No 32659

Permit No. 25888

DFJ-3D-59