


T.3S. R.8½E.W.M.

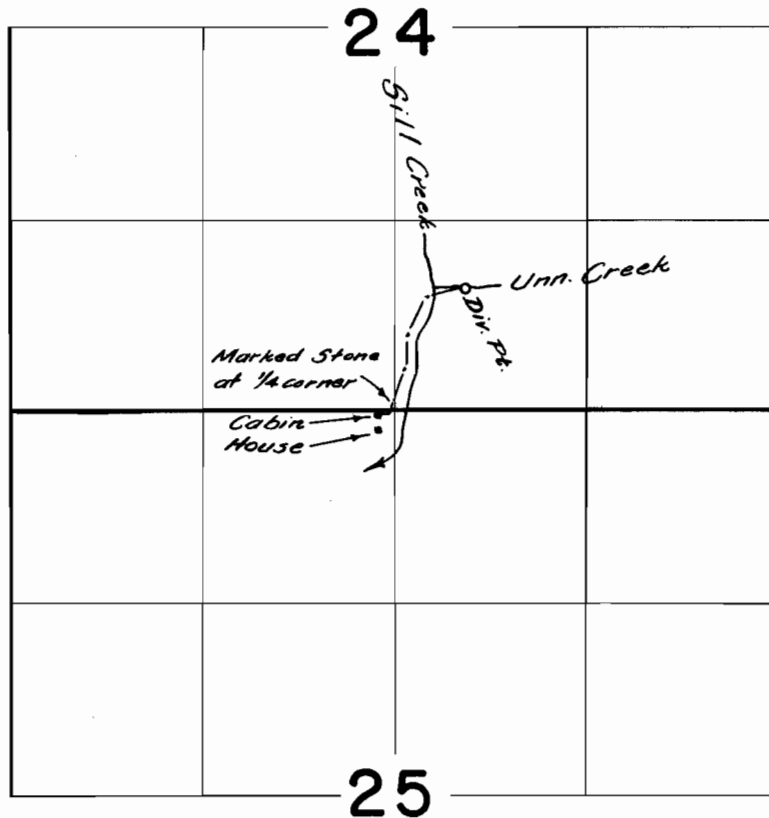

FINAL PROOF SURVEY
UNDER

Application No. 23315 Permit No. 18388
IN NAME OF

ARTHUR W. & HELEN B. WILSON

Surveyed JULY 3 1961, by M. BIER