


T.2S.R. 4E.W.M.

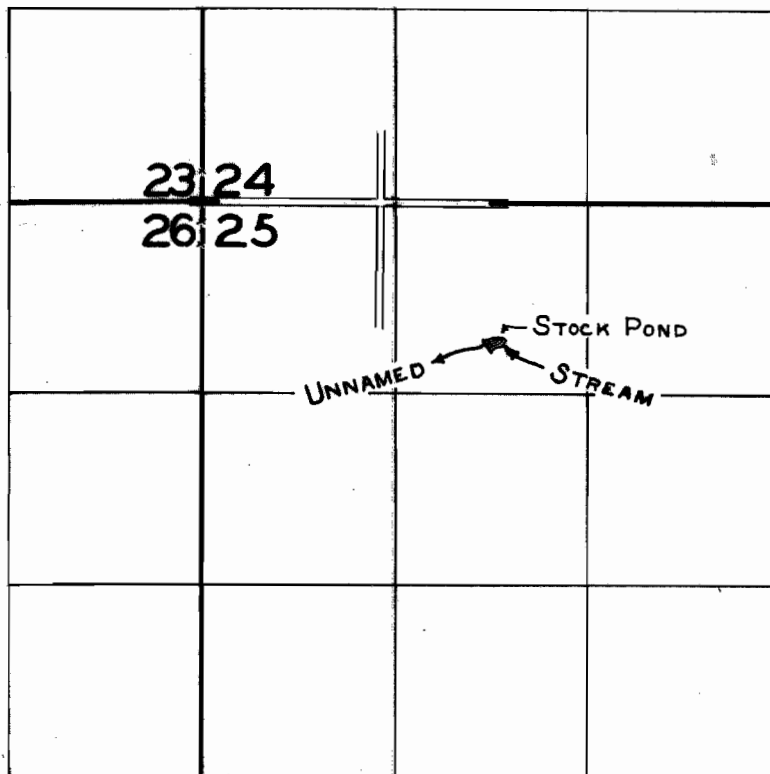

FINAL PROOF SURVEY
UNDER

Application No. R-30832 Permit No. R-1889
30833 IN NAME OF

NORMAN O. ISAKSON

Surveyed AUG 23 1960, by M. BISH

1960E