


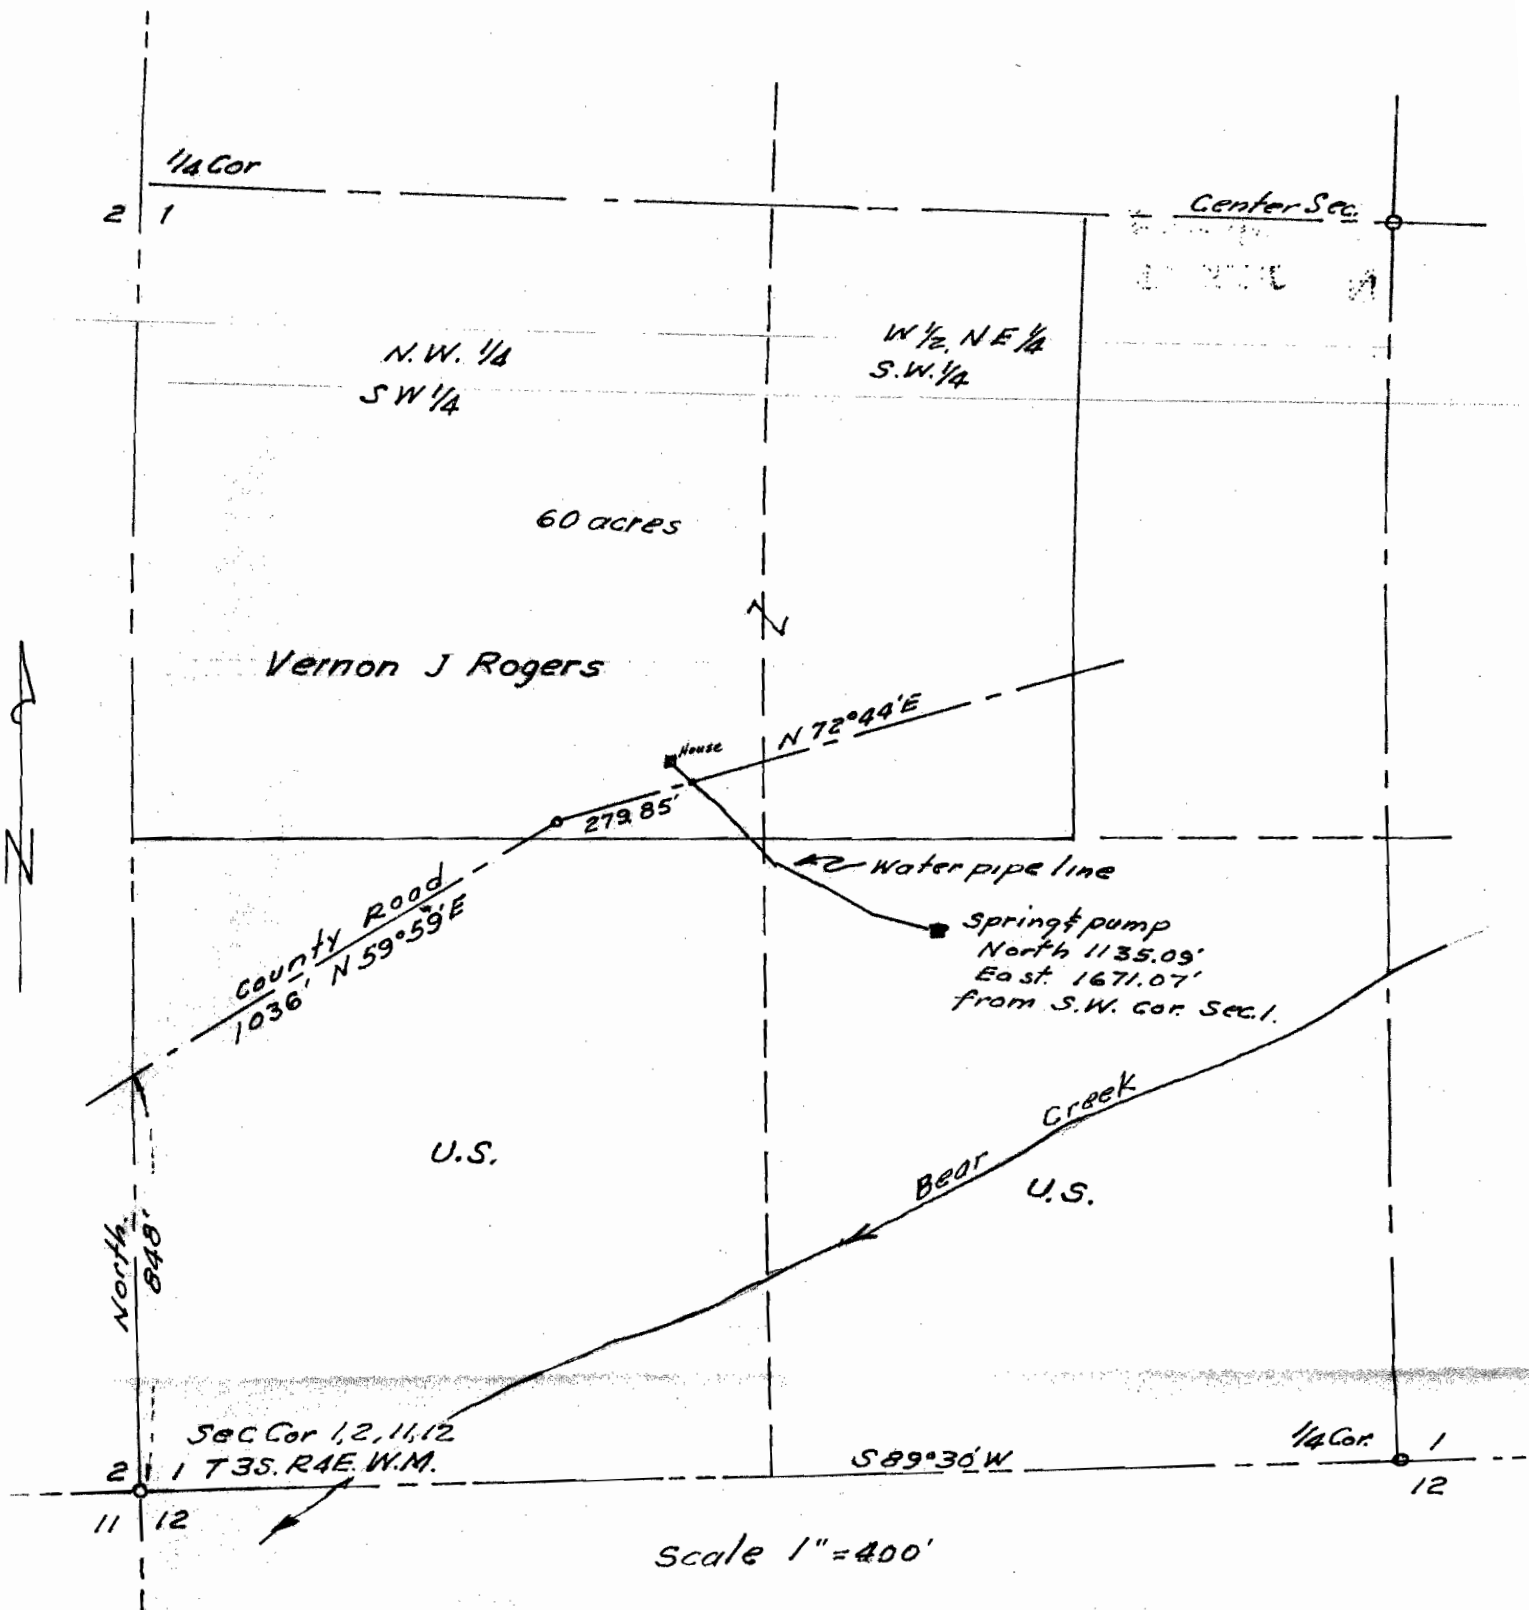

Survey of Right-of-way for Spring & Pump
house & Right-of-way for pipe line
Beginning at Spring said point being
North 1135.09' and East 1671.07' of the SW Cor.
Sec 1, T 3S, R 4E W.M. Clackamas County Ore.
thence from Spring on Right-of-way of pipe line.
N 81° W 51.80'
N 75° 32' W 68.55'
N 62° 29' W 124.84'
N 61° 12' W 104.37'
N 46° 48' W 87.19'
N 45° 30' W 173.16'

REGISTERED
OREGON
LAND SURVEYOR

George C. McAdams

OCT 22, 1964
GEORGE C. MCADAMS
333

GEORGE C. MCADAMS
6518 S.E. DIVISION

PHONE PR. 1-3091
Portland Ore.

Application No. 3290

Permit No. 95979