




Application No. 32592
Permit No. 25722

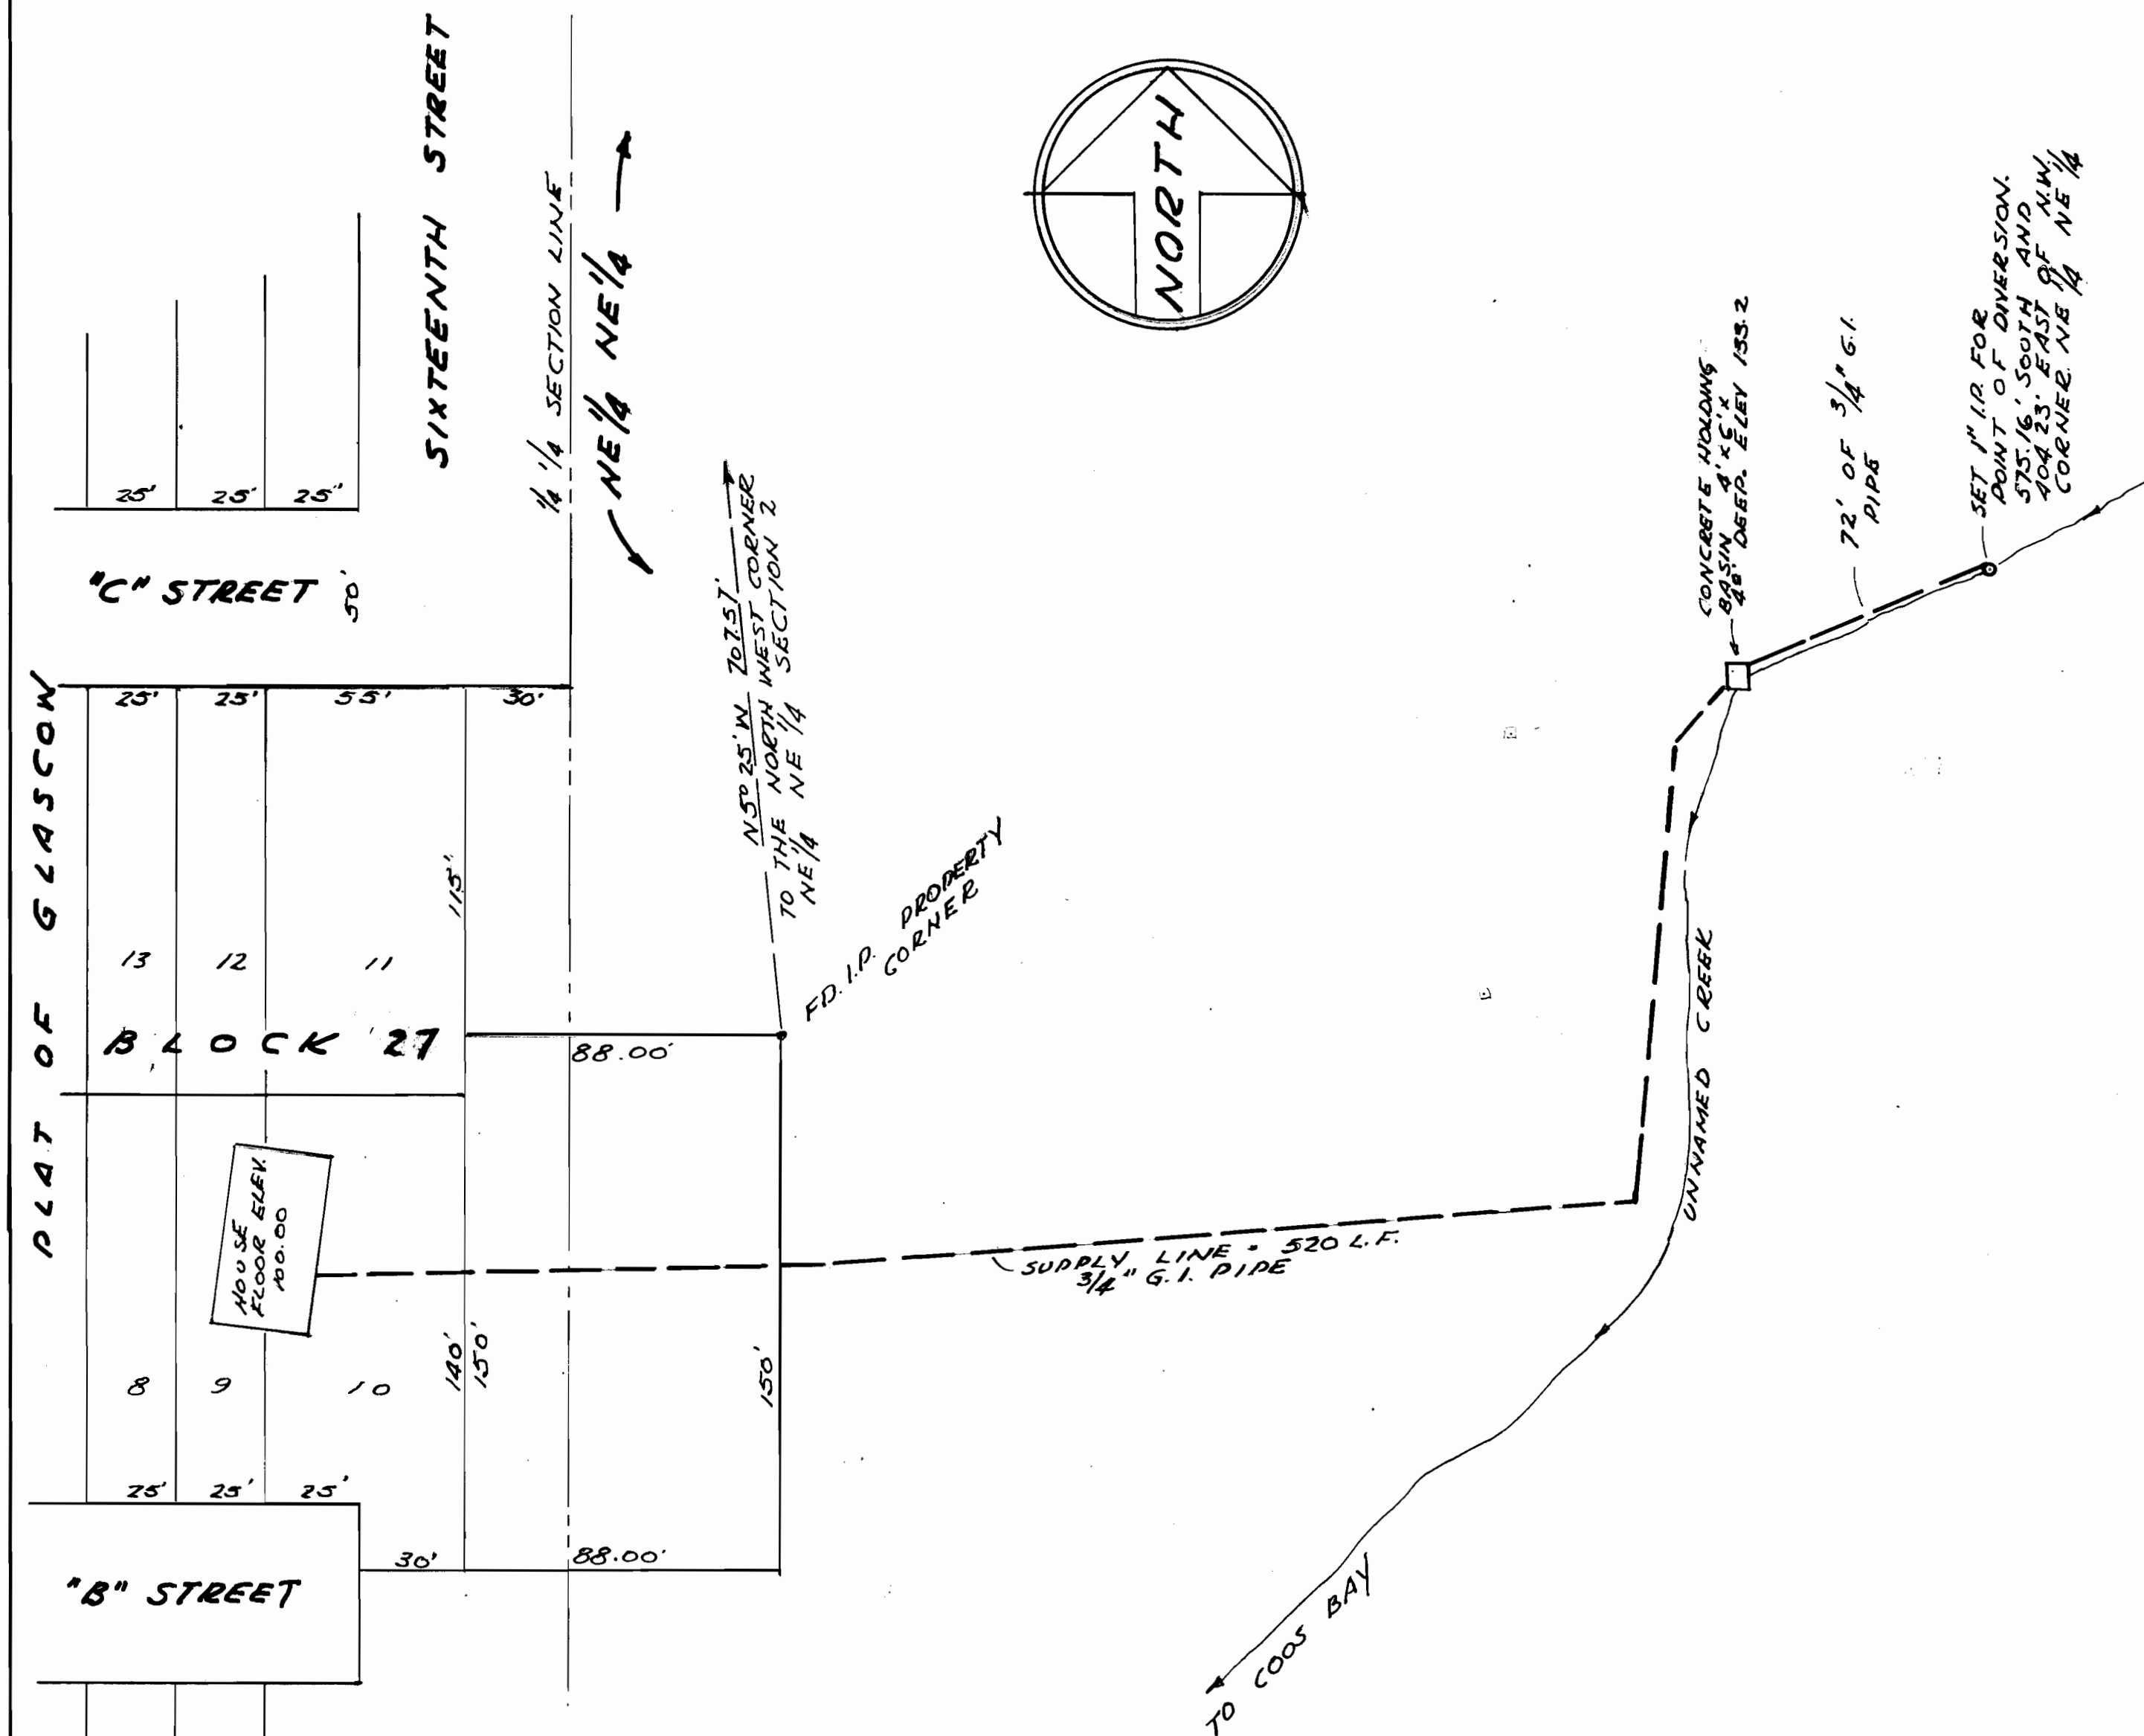

WATER RIGHTS SURVEY
FOR: MR. GEORGE GRANFORS
LOCATED IN THE NE 1/4, NE 1/4
SECTION 2, TOWNSHIP 25 SOUTH
RANGE 13 W.W.M., COOS COUNTY,
OREGON
SCALE: 1" = 40' AUGUST 12, 1958
R.H. ERICHSEN CONSULTING ENGINEER
409 N. 4TH COURT
COOS BAY, OREGON
Route 2 Box 618 N.B.