


T.14S. R.16 E.W.M.

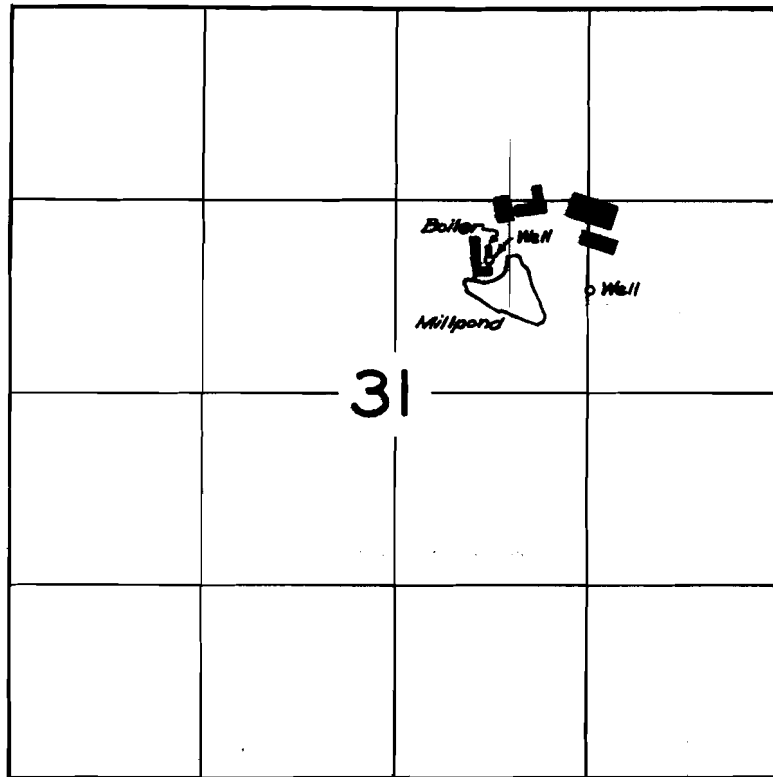

FINAL PROOF SURVEY UNDER

Application No. U-232 Permit No. U-212
IN NAME OF

Hudspeth Sawmill Co.

Surveyed April 28 1955, by T. Jones
Sept. 28 1960 R. Jackson