


T.14S.R.15E.W.M.

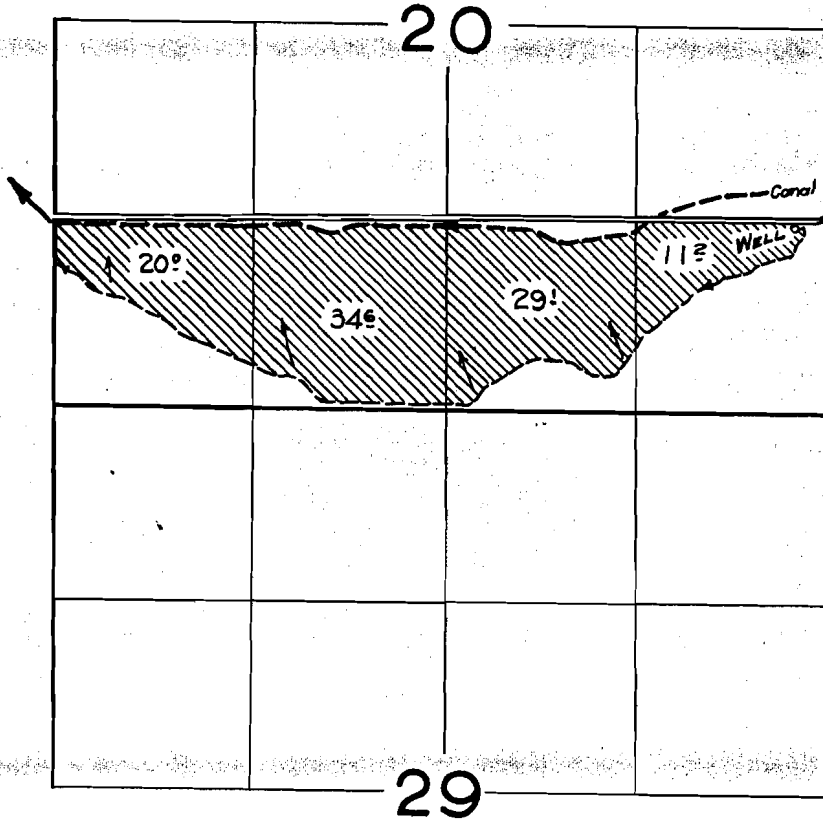

FINAL PROOF SURVEY UNDER

Application No. G-85 Permit No. G-96
IN NAME OF

Hudspeth Land & Livestock Co.

Surveyed Sept. 27 1960, by [Signature]