


T.14S. R.16E.W.M.

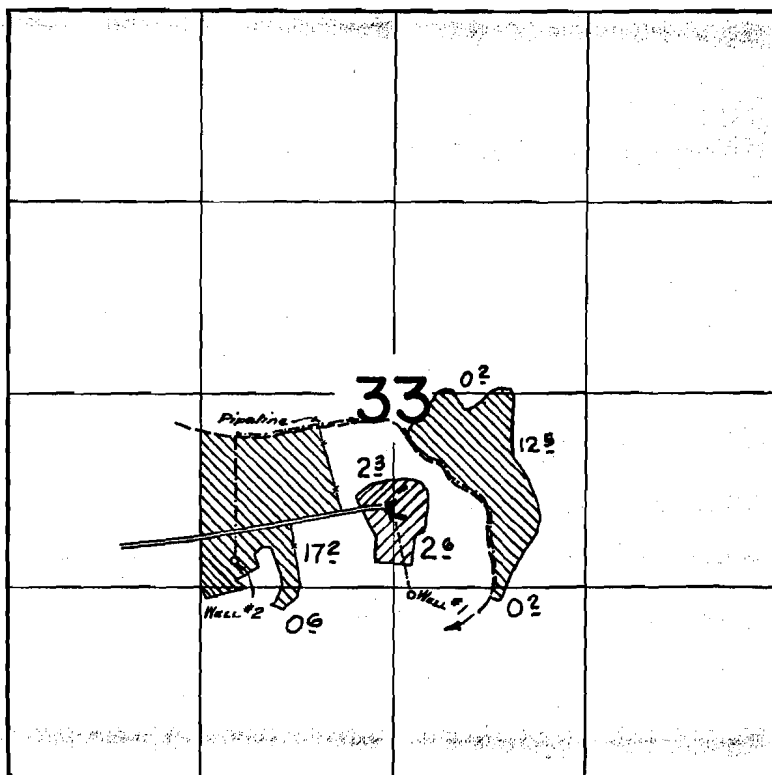

FINAL PROOF SURVEY UNDER

Application No. G-81 Permit No. G-412
IN NAME OF

John & Floreine Hudspeth

Surveyed Sept. 27 1960, by [Signature]