


T. 16 S. R. 20 E. W.M..

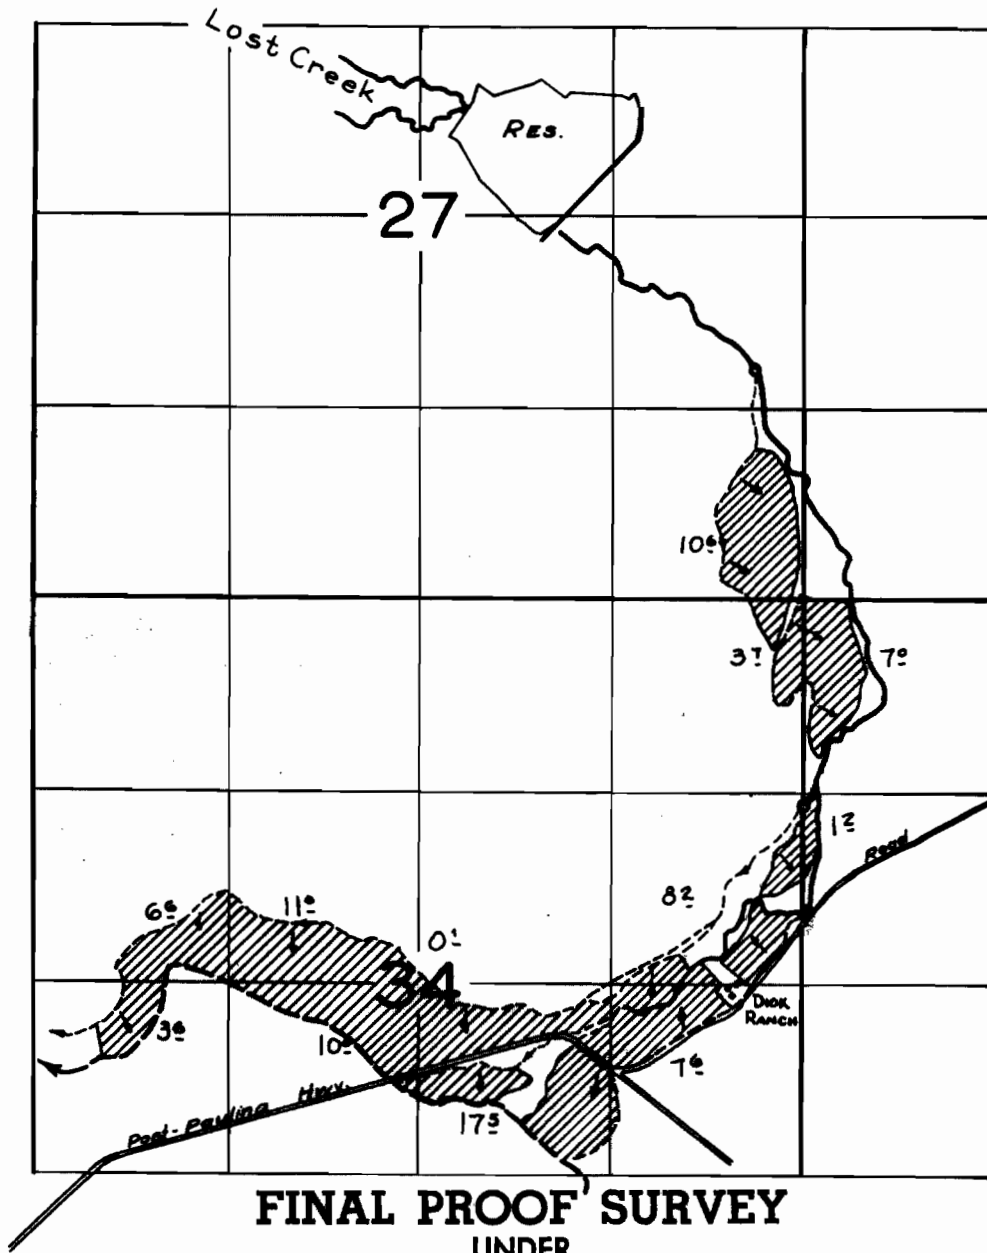

R-22129 R-867
Application No. 22138 Permit No. 17331
IN NAME OF

HUDSPETH LAND & LIVESTOCK CO.

Surveyed Oct. 6, 1960, by *R. Jackson*