


T.14S.R.16E.W.M.

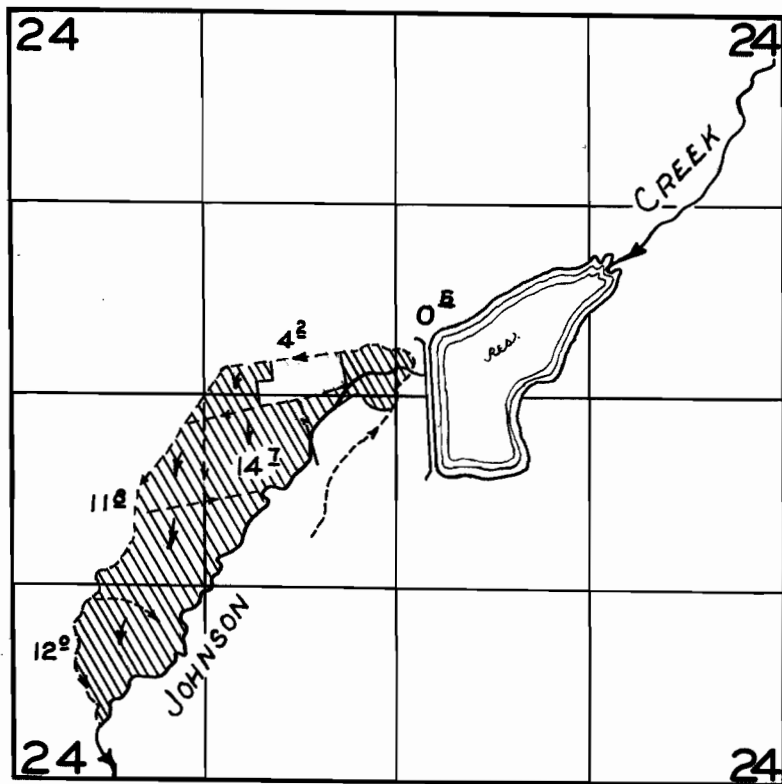

FINAL PROOF SURVEY  
UNDER

Application No. <sup>R-25574</sup> 26457 Permit No. <sup>R-1303</sup> 21003  
IN NAME OF

..... CLAUDE HUDSPETH .....

Surveyed Oct. 7, 1960, by *[Signature]*