


T.15S. R.14E.W.M.

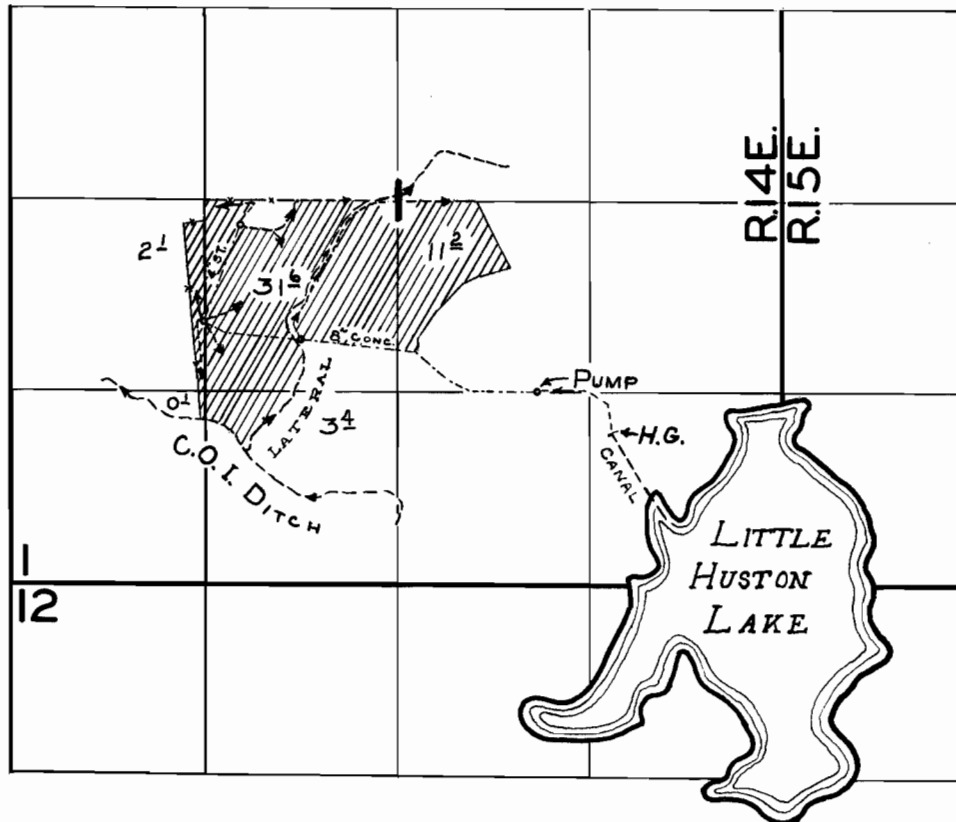

FINAL PROOF SURVEY
UNDER

Application No. 28341 Permit No. 23228
IN NAME OF

H. E. ROBERTS

Surveyed Oct. 5, 1960, by M. BISH

DCY-3H-43