


T.14S.R.16E.W.M.

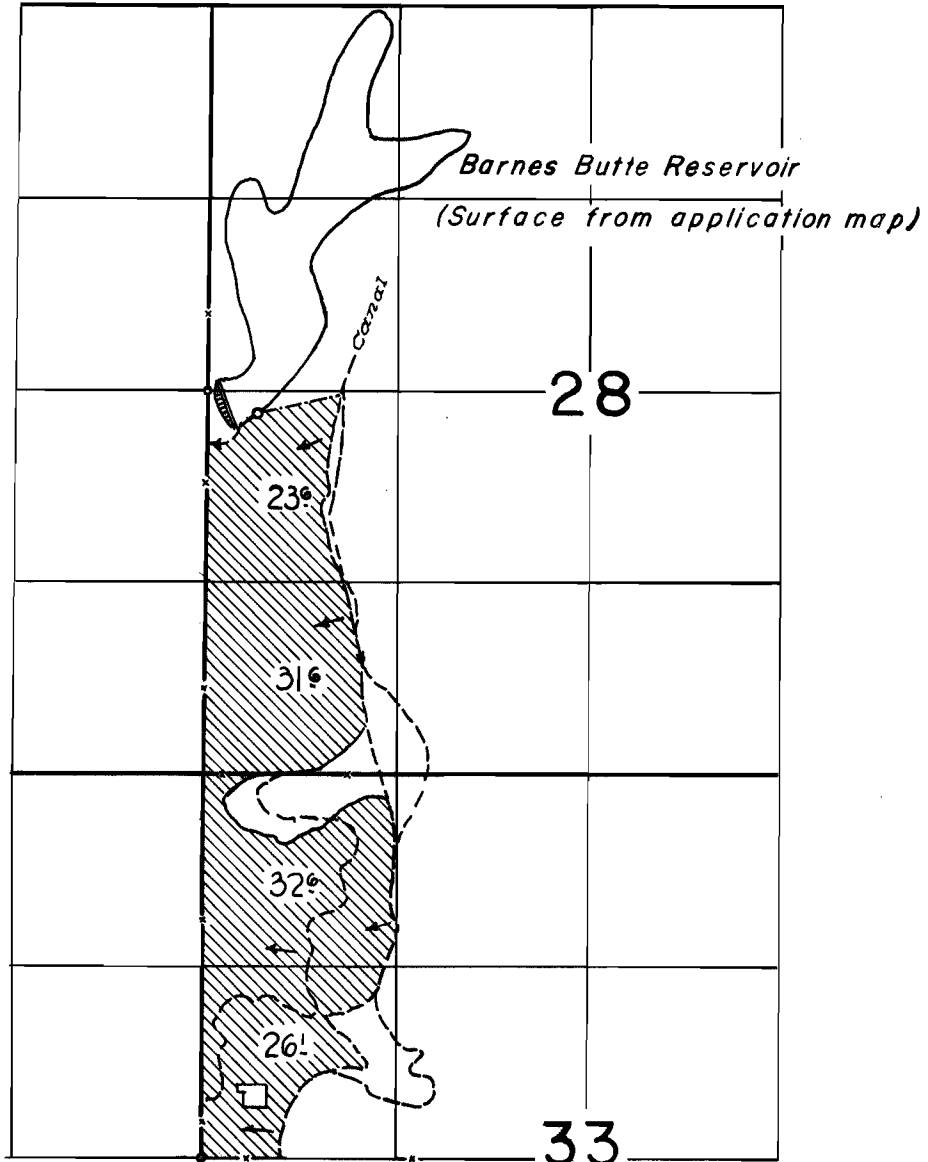

FINAL PROOF SURVEY
UNDER

Application No. 29610 R-29611 29612 Permit No. 23496 R-1734 23497....
IN NAME OF

John Hudspeth

Surveyed Sept. 27 1960, by *[Signature]*