


T.16 S.R.16 E.W.M.

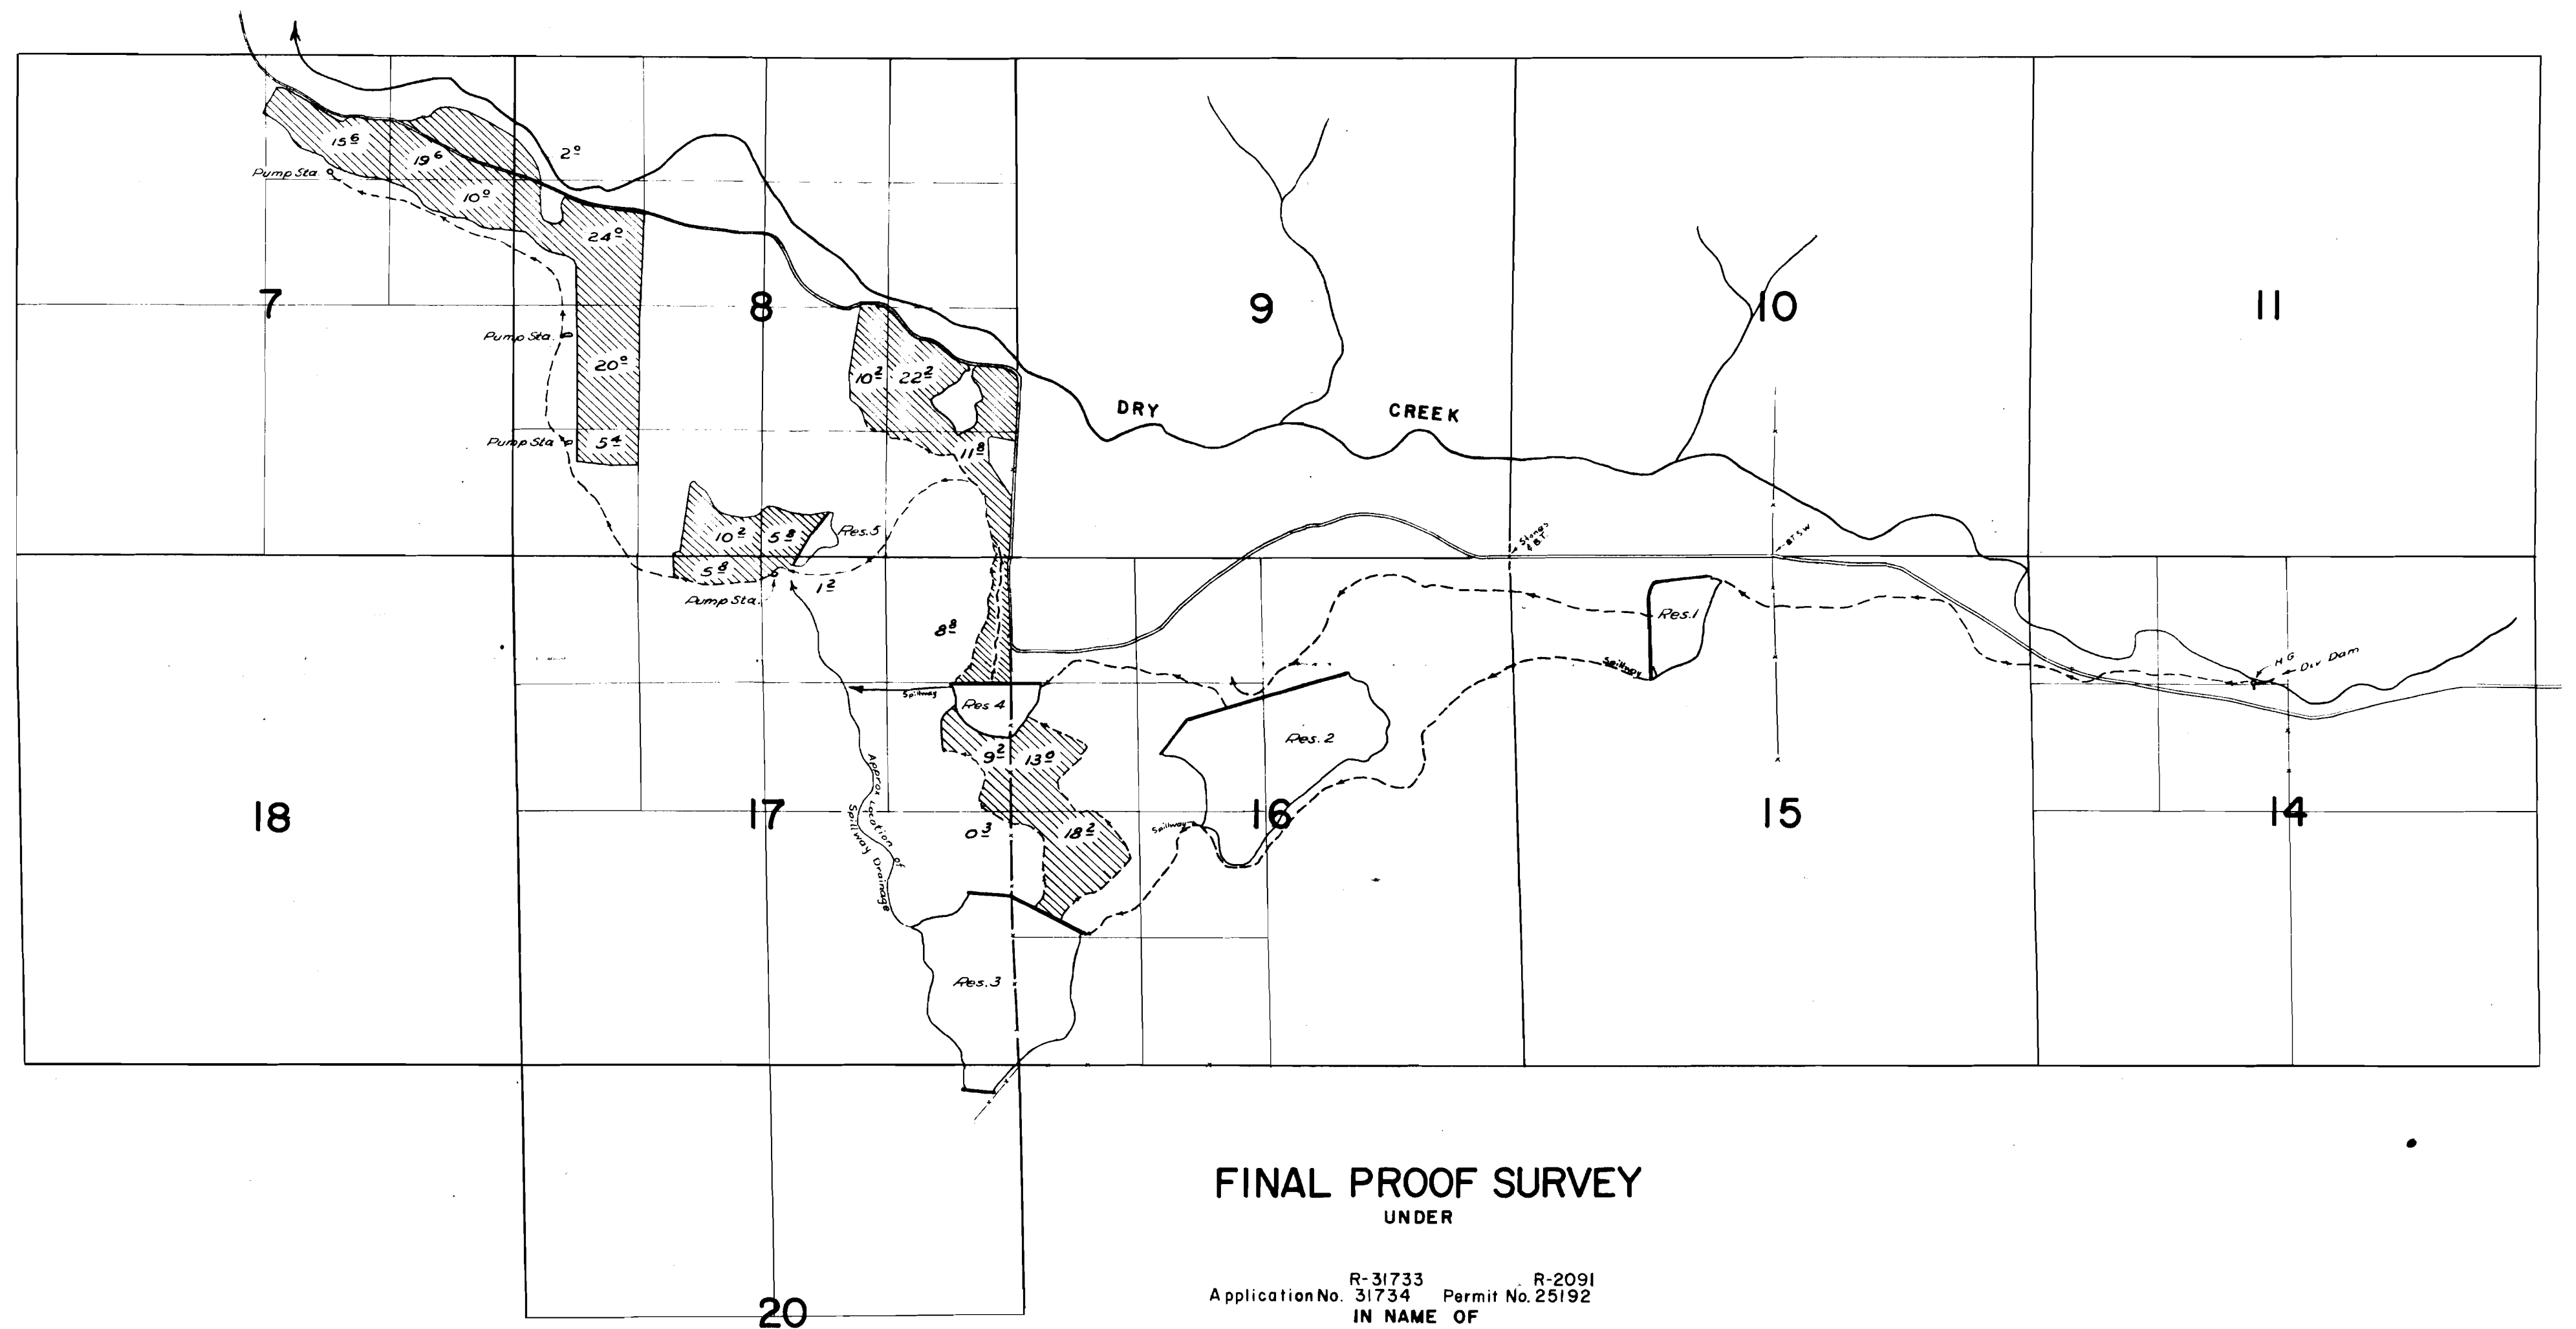

FINAL PROOF SURVEY
UNDER

R-31733 R-2091
Application No. 31734 Permit No. 25192
IN NAME OF

HARRY I. STEARNS

Surveyed 6-7 Oct. 1960 by *T. B. Bish*