


T.16 S.R.16 E.W.M.

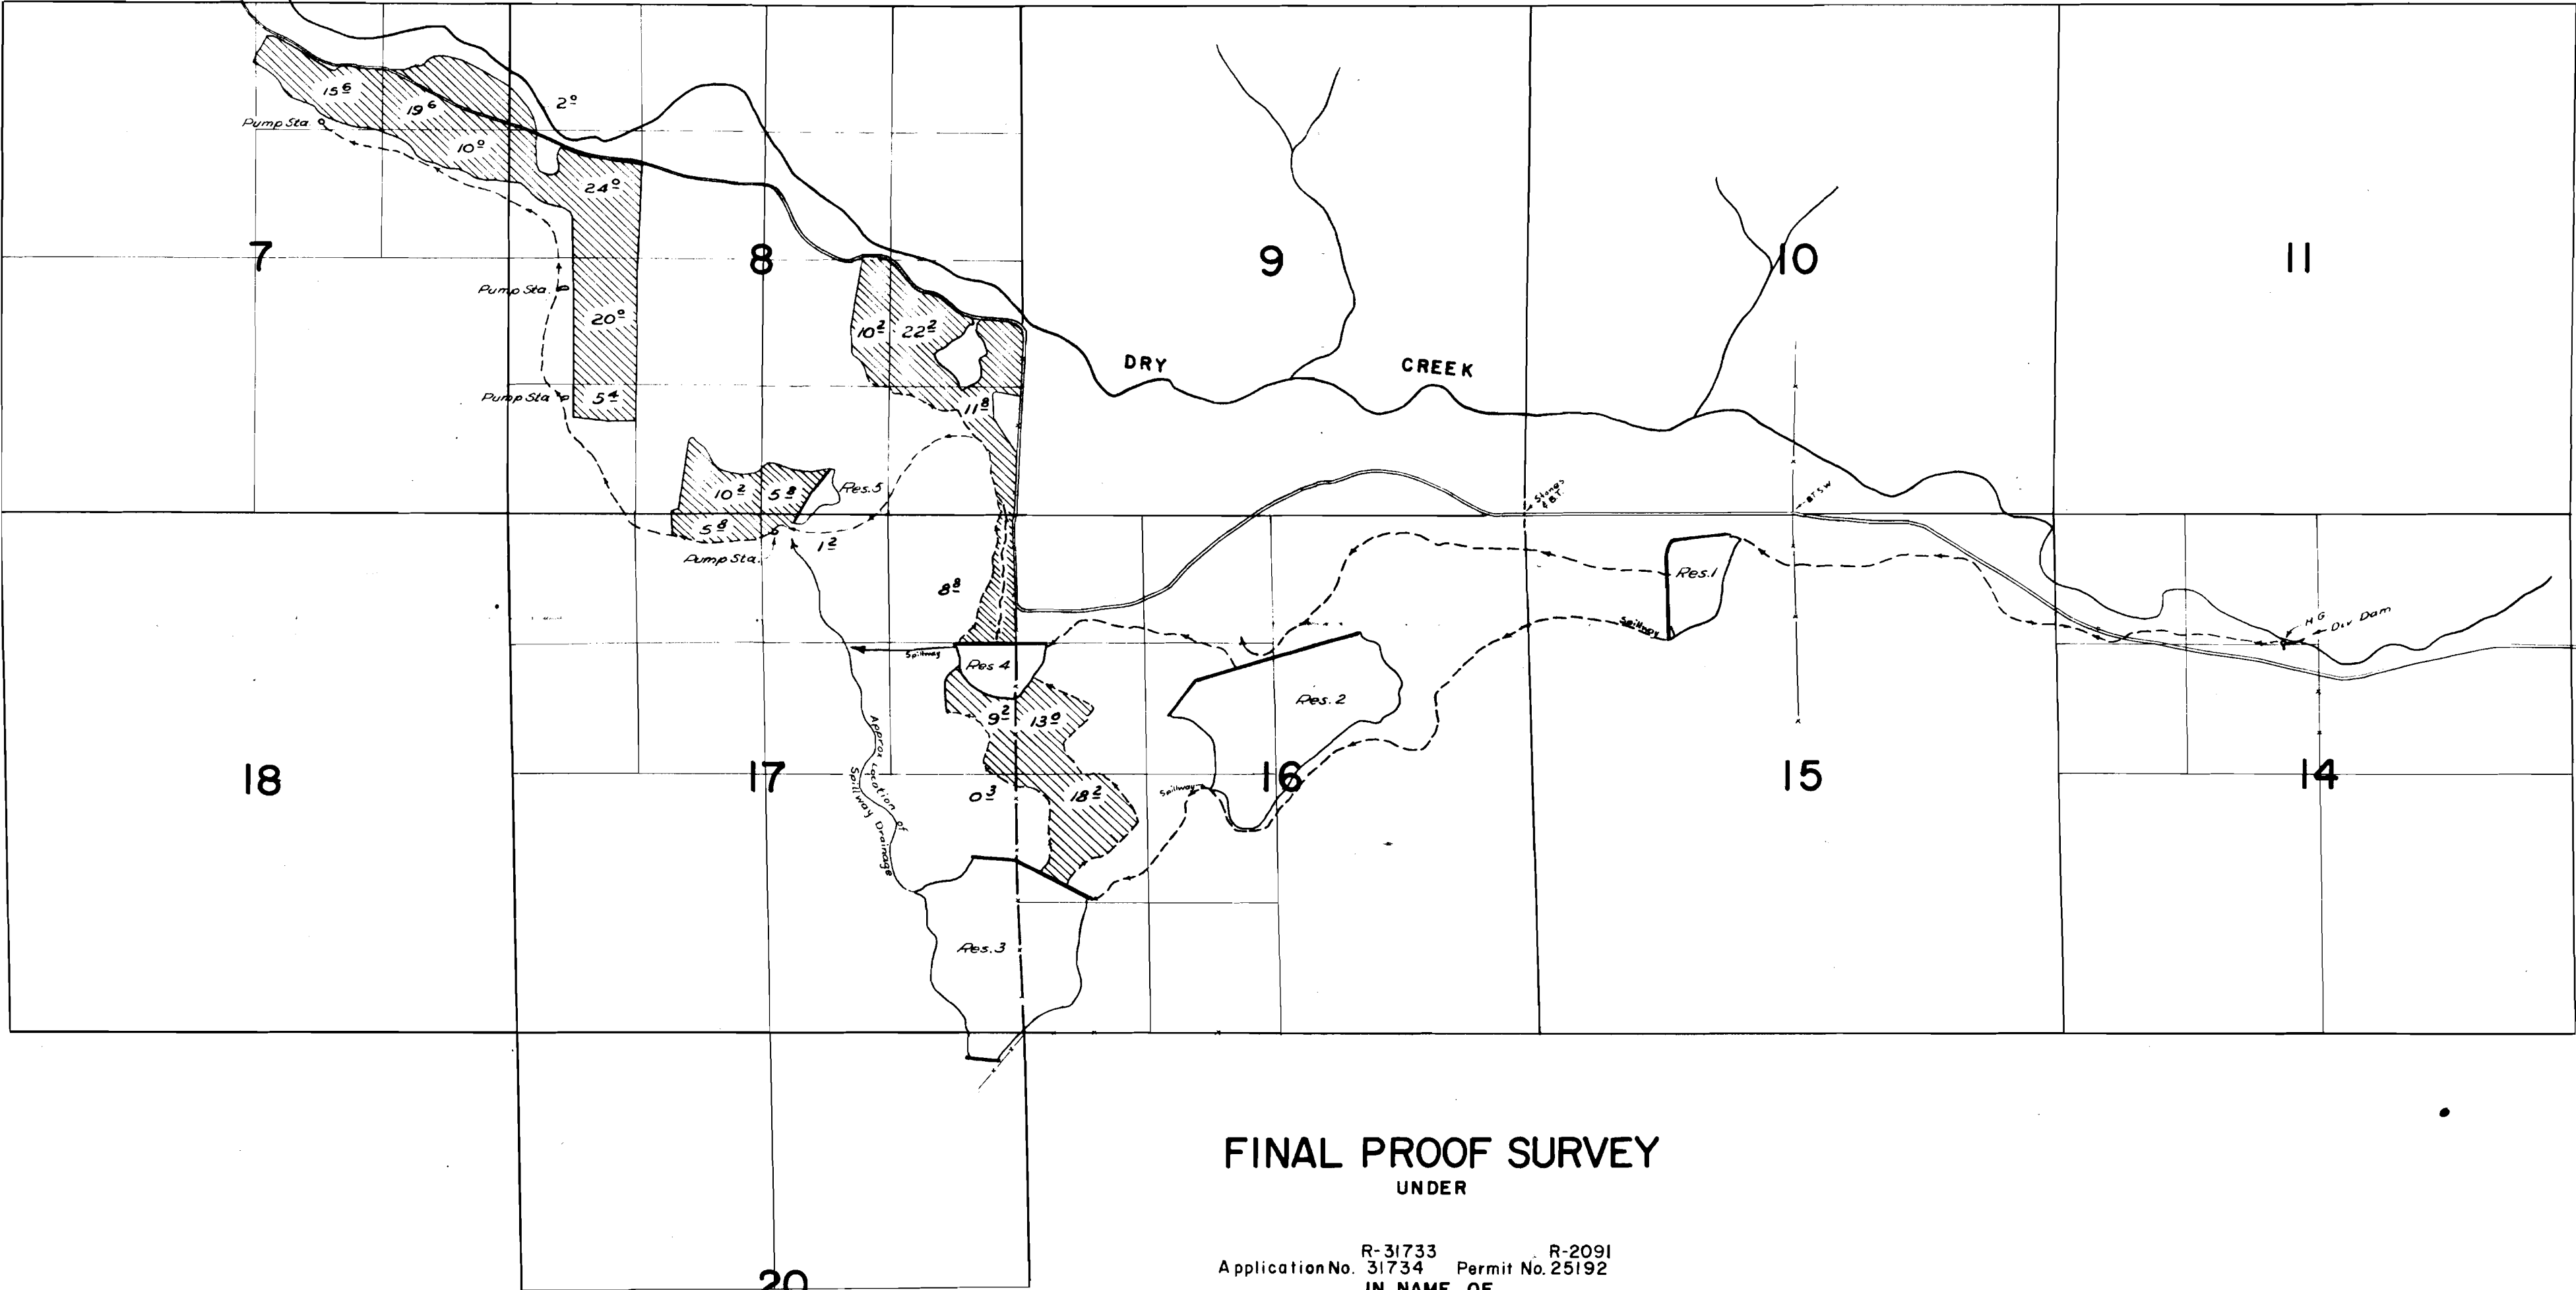

FINAL PROOF SURVEY

Application No. **R-31733** Permit No. **R-209**
31734 **25192**
IN NAME OF

HARRY I. STEARNS

Surveyed 6-7 Oct. 1960 by *Wm. Bish*

1960F & 1960A
DCY-9H-30
DCY-8H-147
DCY-9H-32
DCY-9H-94