

F.A.J. DE HAAN TRACT

SECT. 10 - T26S - R3W - W.M.
DOUGLAS COUNTY
OREGON

RECEIVED
AUG 25 1954
STATE ENGINEER
SALEM, OREGON


Surveyed & Platted By
JAMES R. DAUGHERTY
CIVIL-SANITARY ENGINEER
ROSEBURG - ORE.

Sept. 1952.

Data underlined added Oct. 20, 1954 as requested by letter Oct. 15, James R. Daugherty.



Application No. 29435
Permit No. 23671

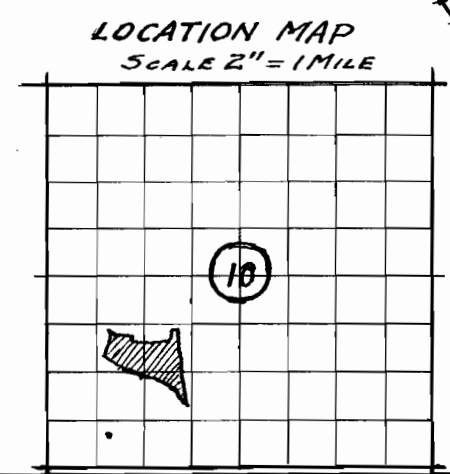

29435